

**LAND CORNER RECORDATION CERTIFICATE**  
**Filing Requirement of Act 74, Mich. P.A. 1970**

Register's Office }  
 Gogebic County } ss.

Received for record the  
22<sup>nd</sup> day of JUNE  
 A. D. 2000 at 11:20 o'clock  
P m., and recorded in  
 Liber 7 of CORNERS  
 on page 395  
*Christy Ruppel, Dep.*  
 Register of Deeds

For corners in

Gogebic Located In: Corner Code #  
 (County)

1. Public Land Survey T46 N R46 W. F-11  
 T \_\_\_ R \_\_\_  
 T \_\_\_ R \_\_\_ SURVEY &  
 T \_\_\_ R \_\_\_ MONUMENTATION

2. Property Controlling S \_\_\_ T \_\_\_ R \_\_\_  
 in Section S \_\_\_ T \_\_\_ R \_\_\_

3. Miscellaneous S \_\_\_ T \_\_\_ R \_\_\_  
 Property in Sec. S \_\_\_ T \_\_\_ R \_\_\_

**JAN 05 2001**  
**SECTION**

Register of Deeds Stamp & File Number

4. Lot No. \_\_\_\_\_, Recorded Plat \_\_\_\_\_  
 5. Private Claims \_\_\_\_\_

Quarter Corner 28 & 33; T.46 N., R.46 W.

I, Richard L. Drahn, in a field survey on June 10, 2000 do hereby state that under requirements of P.A. 74, Michigan P.A. of 1970, the corner points mentioned in lines 1 and 2 above were in conformance with regulations and rules therefore as required in the current manual of survey instructions of the United States Department of the Interior, Bureau of Land Management or by a decree of a Court of Law and /or that the corner points mentioned in lines 3, 4 and 5 above were in conformance with the rules of the Michigan Board of Land Surveyors or by a Decree of a Court of Law; established, re-established, monumented, recovered, found as expressed below:

**NOTE: Not more than 2 corners, all in the same town and range, may be recorded on this certificate.**

A	B	C	D	E	F	G	H	I	J	K	L	M
1												
2	6	5	4	3	2	1						
3												
4	7	8	9	10	11	12						
5												
6	18	17	16	15	14	13						
7												
8	19	20	21	22	23	24						
9												
10	30	29	28	27	26	25						
11												
12	31	32	33	34	35	36						
13												

A. Description of original monument and accessories and/or subsequent restoration:

Original corner established by Austin Burt on 7/10/1851. Original bearing trees:

Hemlock	11"	S.58 W.	34 links	(22.44')
Hemlock	12"	N.35 E.	23 links	(15.18')

B. Description of corner evidence found and/or method applied in restoring or reestablishing corner:

I restored the corner position at record bearing and distance from the remains of the two bearing trees. The first is a large windthrown stump hole. The second one is now portions of a very badly decayed Hemlock stump. Hemlock bark, roots, knots and some Hemlock wood is all that remains.


A ribboned line intersect, for lines running south and east, bears N.09 W. 13.4 feet.

Corner research on file with Gogebic County records.

C. Description of monument for corner and accessories established to perpetuate locating the position of the corner:

At the corner position I set a 3/4" X 4' aluminum rod monument with a 3 1/4" stamped aluminum cap and the following new B.T.s (all measurements taken to a nail in side of tree):

Yellow Birch	9"	N.09 W.	13.36'
Red Maple	8"	S.48 E.	22.89'
Red Maple	6"	S.60 W.	42.88'
Steel sign rail	6'	S.17 W.	2.37'

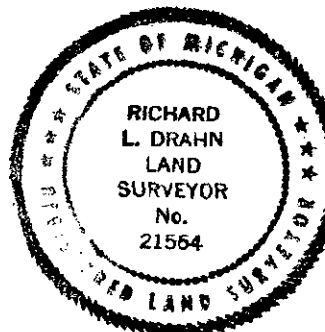

*Richard L. Drahn*  
 REGISTERED LAND SURVEYOR  
 No. 21564

Signed by Richard L. Drahn Date June 14, 2000  
 Surveyor's Michigan License No. 21564