

DEC 15 1998

SECTION

LAND CORNER RECORDATION CERTIFICATE
Filing Requirement of Act 74, Mich. P.A. 1970

For corners in

Gogebic (County)

Located In:

Corner Code #

- 1. Public Land Survey
 - T 46N R45W A-1
 - T 47N R45W A-13
 - T 46N R46W M-1
 - T 47N R46W M-13
- 2. Property Controlling in Section
 - S T R
 - S T R
- 3. Miscellaneous Property in Sec.
 - S T R
 - S T R

- 4. Lot No. _____, Recorded Plat _____
- 5. Private Claims _____

Section Corner 6, 1, 31 & 36; T.46-47 N., R.45-46 W.

Richard L. Drahn, in a field survey on October 2, 19 98, do hereby certify that under requirements of P.A. 74, Michigan P.A. of 1970, the corner points mentioned in lines 1 and 2 above were in conformance with regulations and rules therefore as required in the current manual of survey instructions of the United States Department of the Interior, Bureau of Land Management or by a decree of a Court of Law and/or that the corner points mentioned in lines 3, 4 and 5 above were in conformance with the rules of the Michigan Board of Land Surveyors or by a Decree of a Court of Law; established, re-established, monumented, re-monumented, recovered, found as expressed below:

NOTE: Not more than 4 corners, all in the same town and range, may be recorded on this certificate.

A. Description of original monument and accessories and/or subsequent restoration:

Corner established by Austin Burt on 8/31/1847. Original B.T.s --- Y. Birch 18" S.34 E. 35 links (23.10') --- Cedar 12" N.66 W. 35 links (23.10') --- R.G. Campbell, on 7/26/35 recovered both BT's still scribed and placed a location poster on the south side of a 16" Black Ash.

B. Description of corner evidence found and/or method applied in restoring or reestablishing corner:

Restored corner position at record bearing and distance from the remains of the two original BT's. The first one is a badly decayed 20-22" Yellow Birch stump. The second one is now a downed, badly decayed 14-18" Cedar with evidence of the GLO blaze overgrowth still present. Campbell's tag tree is now a broken 20-24" Black Ash stub bearing N.72 W. 9.0' from the original corner location. Unable to find his location poster. Corner research on file with Gogebic County records.

DEER GROUP APPROVED
Richard L. Drahn 10/27/98
COUNTY REGISTERED SURVEYOR

C. Description of monument for corner and accessories established to perpetuate locating the position of the corner:

At the corner position I set a 3/4" X 4' solid aluminum rod with a 3 1/4" stamped aluminum cap and the following new bearing objects


9"	Hemlock	N.60 E.	15.35'
16"	Hemlock	N.13 E.	16.24'
6"	Black Ash	S.44 W.	20.55'
6'	Steel sign rail	S.79 W.	1.50'

A 3/4" iron pipe and two posts bears S.09 W., 12.9'

Register's Office }
Gogebic County } ss.

Received for record the
30th day of OCTOBER
A. D. 1998 at 9:05 o'clock
A m., and recorded in
Liber 7 of CORNERS
on page 63.
Ramona Collins, Deputy
Register of Deeds

Register of Deeds Stamp & File Number

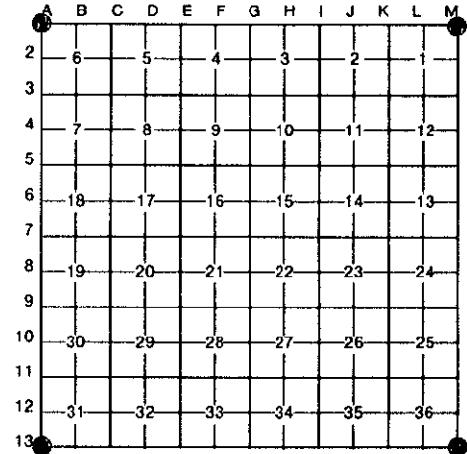

Signed by Richard L. Drahn Date October 6, 1998

Surveyor's Michigan License No. 21564

