

SURVEY &
REMONUMENTATION


JAN 20 1999

LAND CORNER MONUMENTS

SECTION

T. 46 N., R. 46 W.

ERWIN TOWNSHIP

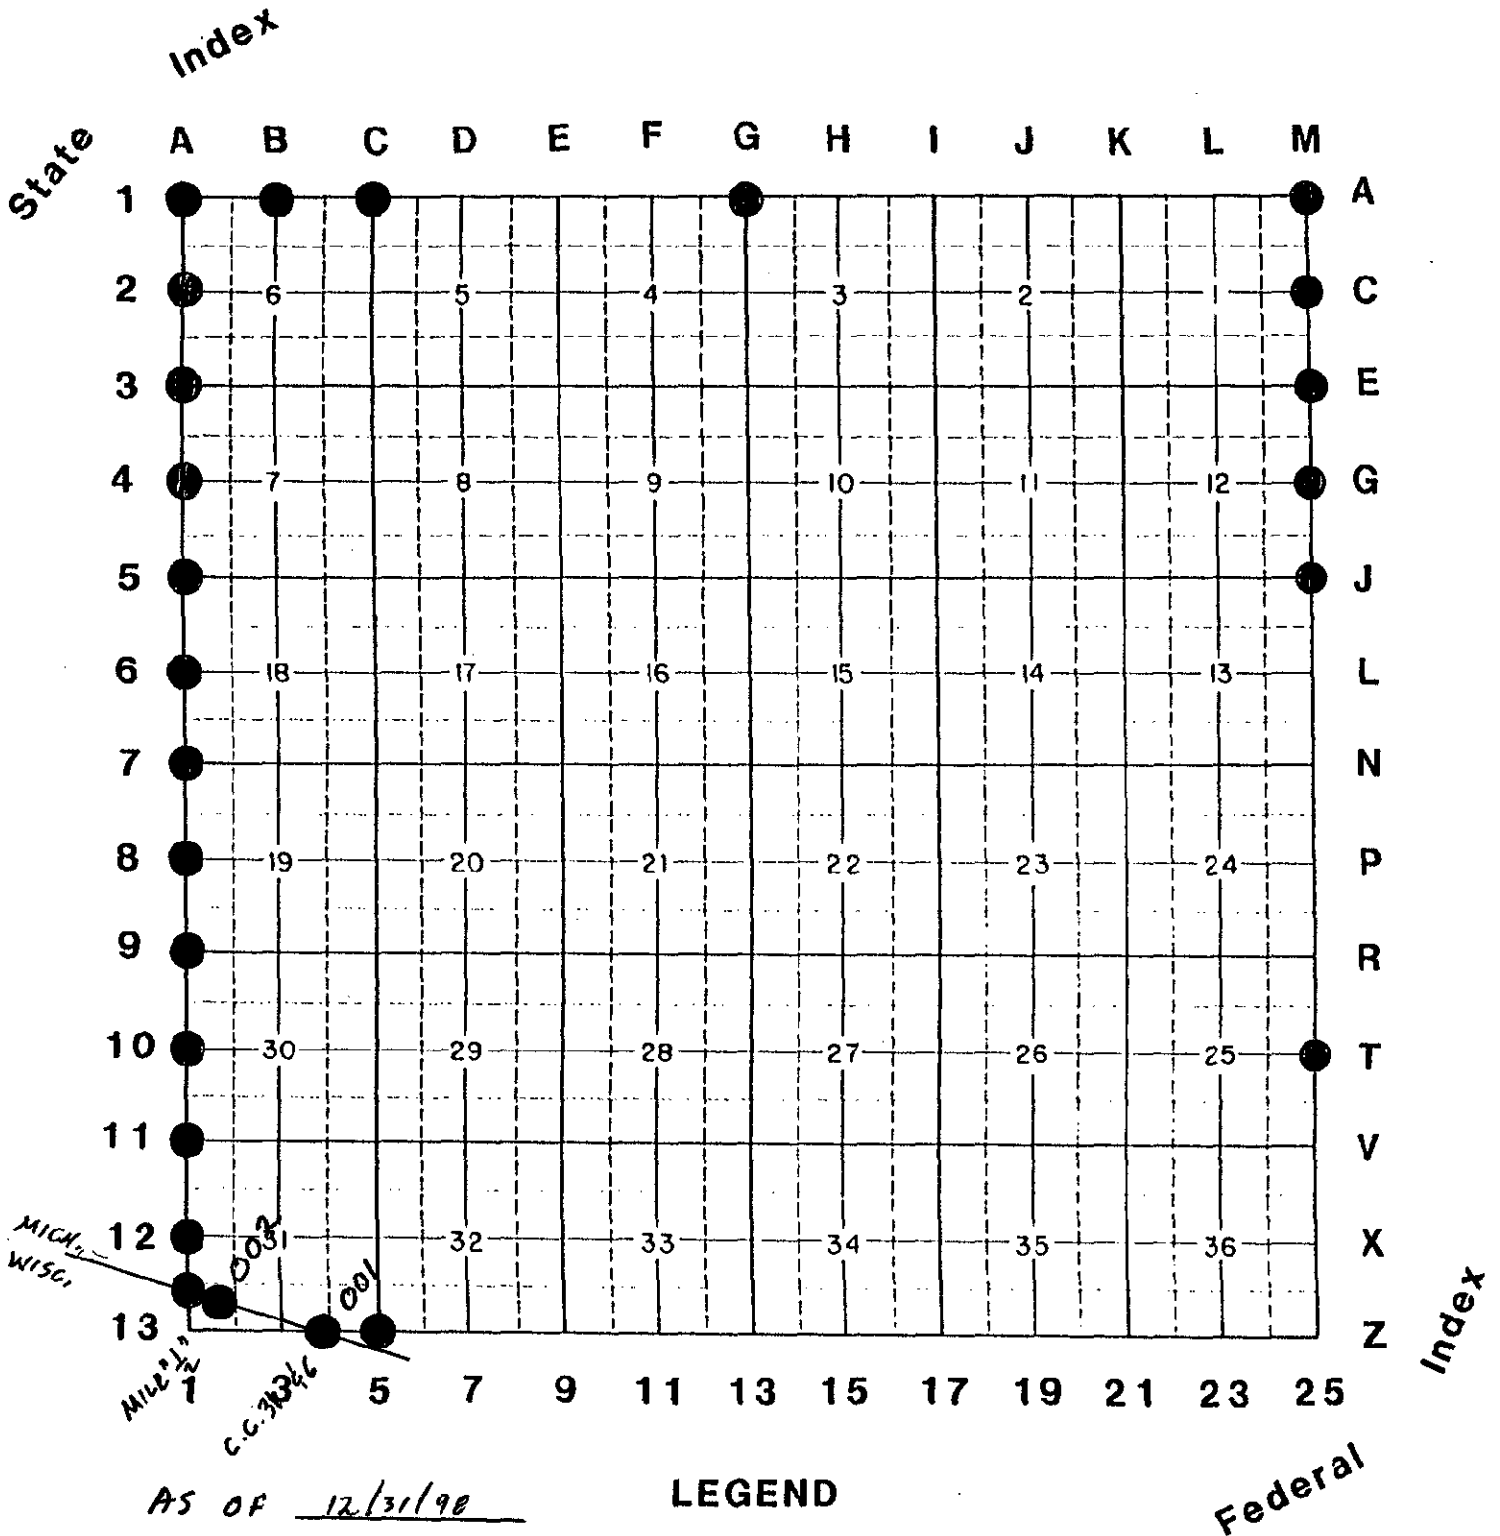

- GLO Corners researched
- ⊙ GLO Corners monumented, not approved
- ⊗ GLO Corners approved
- GLO Corners approved & reported to State

T. 46 N., R. 46 W.