

**SURVEY & REMONUMENTATION**

**JAN 05 2001**

**SECTION**

**LAND CORNER RECORDATION CERTIFICATE**  
**Filing Requirement of Act 74, Mich. P.A. 1970**

Register's office }  
 Gogebic County } ss.

For corners in  
Gogebic  
 (County)

Located in: \_\_\_\_\_ Corner Code # \_\_\_\_\_

1. Public Land Survey T46NR47W J-3  
 T \_\_\_\_\_ R \_\_\_\_\_  
 T \_\_\_\_\_ R \_\_\_\_\_  
 T \_\_\_\_\_ R \_\_\_\_\_

2. Property Controlling S \_\_\_\_\_  
 in Section S \_\_\_\_\_ T \_\_\_\_\_ R \_\_\_\_\_  
 S \_\_\_\_\_ T \_\_\_\_\_ R \_\_\_\_\_

3. Miscellaneous S \_\_\_\_\_  
 Property in Sec. S \_\_\_\_\_ T \_\_\_\_\_ R \_\_\_\_\_

4. Lot No. \_\_\_\_\_, Recorded Plat \_\_\_\_\_

5. Private Claims \_\_\_\_\_

Quarter Corner common to Sections 2 & 11.


Received for record use  
2<sup>ND</sup> day of JUNE  
 A. D. 1900 at 10:20 o'clock  
A m., and recorded in  
 Liber 7 of CORNERS

on page 351  
*Cheryl Rippe, Dep.*  
 Register of Deeds

Register of Deeds Stamp & File Number

I, John R. Garske, in a field survey on April 26, 2000, do hereby state that under requirements of P.A. 74, Michigan P.A. of 1970, the corner points mentioned in lines 1 and 2 above were in conformance with regulations and rules therefore as required in the current manual of survey instructions of the United States Department of the Interior, Bureau of Land Management or by a decree of a Court of Law and / or that the corner points mentioned in lines 3, 4, and 5 above were in conformance with the rules of the Michigan Board of Land Surveyors or by a Decree of a Court of Law; established, re-established, monumented, recovered, found as expressed below.

NOTE: Not more than 2 corners, all in the same town and range, may be recorded on this certificate.

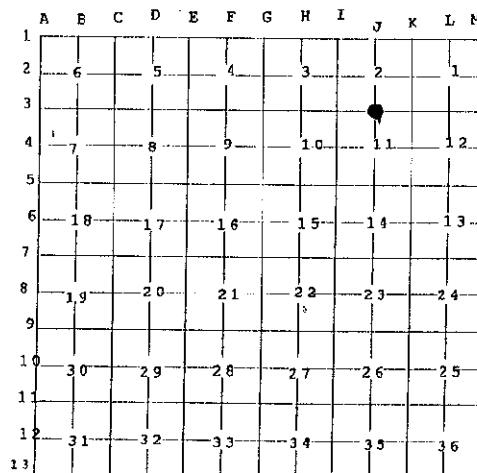

**A. Description of original monument and accessories and / or subsequent restoration:**

Original survey by William Ives in 1848.  
 Original Corner: Wood post  
 Original Bearing Trees: 10" Yellow Birch S 60° E 4 Links  
 5" Fir N 02° W 4 Links

**B. Description of corner evidence found and / or method applied in restoring or re-establishing corner:**

I found an old barbed wire fenceline running West from the East one-sixteenth line (being an old barbed wire fenceline) to a large rock, approximately 130 feet East of the quarter corner position, then runs North. This fence also continues around the rock, breaks, then starts again in the Section line position between Sections 2 and 11, this fenceline then intersects with another ancient barbed wire fenceline running north and south at the quarter corner position.

Record research on file.

(see sketch on back)

**DEED GROUP APPROVED**  
*Richard L. Walsh 5/24/00*  
**COURT RECORDED**

**C. Description of monument for corner and accessories established to perpetuate locating the position of the corner:**

I set a 3/4" aluminum cap mounted on a 4' section of aluminum marsh rod, from which I established the following witnesses:

8" Maple	S 33° E	6.99 Feet
6" Maple	N 48° E	22.17 Feet
14" Maple	N 40° W	33.78 Feet
4' Steel Sign Post	N 61° E	1.64 Feet

Signed by John R. Garske

Date 5/24/00




Surveyor's Michigan License No. 28410  
 FB # 213, page 62, and FB # 251, page 19

SURVEY &  
REMONUMENTATION

JAN 05 2001

SECTION

Not to Scale

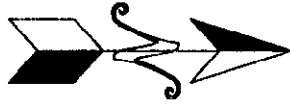

Quarter Corner common to Sections 2 & 11,  
T 46 N, R 47 W.

