

SURVEY & REMONUMENTATION

DEC 15 1998

LAND CORNER RECORDATION CERTIFICATE
Filing Requirement of Act 74, Mich. P.A. 1970

Register's Office } ss.
Gegebic County }

Received for record the
25TH day of NOVEMBER
A. D. 1998 at 10:00 o'clock
A m., and recorded in
Liber 7 of CORNES
page 92
Ramona Collins, Deputy
Register of Deeds

SECTION
For corners in
Gogebic

(County)	Located In:	Corner Code #
	Section <u>2</u> <u>46N</u> <u>47W</u> <u>K-2</u>	
1. Public Land Survey	T ___ R ___	_____
	T ___ R ___	_____
	T ___ R ___	_____
	T ___ R ___	_____
2. Property Controlling in Section	S ___ T ___ R ___	_____
	S ___ T ___ R ___	_____
3. Miscellaneous Property in Sec.	S ___ T ___ R ___	_____
	S ___ T ___ R ___	_____

Register of Deeds Stamp & File Number

4. Lot No. _____, Recorded Plat _____
5. Private Claims _____

1/4 corner 1 & 2, T46N, R47W

I, John R. Garske, in a field survey on 11-19, 1998 do hereby state that under requirements of P.A. 74, Michigan P.A. of 1970, the corner points mentioned in lines 1 and 2 above were in conformance with regulations and rules therefore as required in the current manual of survey instructions of the United States Department of the Interior, Bureau of Land Management or by a decree of a Court of Law and/or that the corner points mentioned in lines 3, 4 and 5 above were in conformance with the rules of the Michigan Board of Land Surveyors or by a Decree of a Court of Law; established, re-established, monumented, recovered, found as expressed below:

NOTE: Not more than 2 corners, all in the same town and range, may be recorded on this certificate.

	A	B	C	D	E	F	G	H	I	J	K	L	M
1													
2	6		5		4		3		2		1		
3													
4	7		8		9		10		11		12		
5													
6	18		17		16		15		14		13		
7													
8	19		20		21		22		23		24		
9													
10	30		29		28		27		26		25		
11													
12	31		32		33		34		35		36		
13													

A. Description of original monument and accessories and/or subsequent restoration:

Original Township Township subdivision by William Ives, D.S. in Sept. 1848.
Original Corner-Tamarack 10" for the quarter corner
DO - 10" N53°E - 21 links

B. Description of corner evidence found and/or method applied in restoring or reestablishing corner:

I established the 1/4 corner at the intersection of Hendrickson and VanBuskirk Roads. A thorough search of the area could find no evidence of a corner location. Measurements along VanBuskirk Road to East-West fence line crossing fit will with this location. S00° - 35' - 32" W - 2645.79 feet to the 1,2,11,12 section corner and N00° - 18' - 05" E - 2635.21 feet to the 1,2,35,36 section corner.

(Research on file)

DEED GROUP APPROVAL
Richard R. Dzialo 11/24/98
COUNTY REGISTER

C. Description of monument for corner and accessories established to perpetuate locating the position of the corner:


At the 1/4 corner position in the centerline of the roads I set 2 1/2" magnetic P.K. nail from which I established:

2 reference monuments; consisting of 3/4" dia. x 48" long aluminum rods with a 3 1/4" dia stamped aluminum cap.

- RM 1 N48°W 47.00 feet, sign rail - 1.00 feet
- RM 2 S85°E 33.00 feet, sign rail - 1.00 feet
- Power Pole S50°W 46.59 feet
- Power Pole S38°E 47.00 feet

Signed by John R. Garske
Surveyor's Michigan License No. 28410

Date 11/24/98

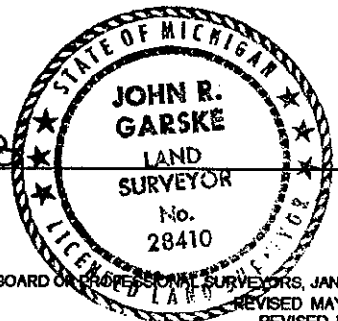

SURVEY &
REMONUMENTATION

DEC 15 1998

SECTION

1/4 COR. 201 T46N, R47W

