

**SURVEY & MONUMENTATION**

**JAN 05 2001**

**SECTION**

**LAND CORNER RECORDATION CERTIFICATE**  
Filing Requirement of Act 74, Mich. P.A. 1970

Register's Office }  
Gogebic County } ss.

For corners in  
Gogebic  
(County)

Located in: Corner Code #

1. Public Land Survey T46NR47W K-6  
T    R     
T    R     
T    R   

2. Property Controlling S    T    R     
in Section S    T    R   

3. Miscellaneous S    T    R     
Property in Sec. S    T    R   

4. Lot No.   , Recorded Plat   

5. Private Claims   

Quarter Corner common to Sections 13 and 14.

Received for record the  
2<sup>ND</sup> day of JUNE  
A. D. 2000 at 10:20 o'clock  
A m., and recorded in  
Liber 7 of CORNERS  
page 352  
*Cheryl Rippe, Dep.*  
Register of Deeds

Register of Deeds Stamp & File Number

I, John R. Garske, in a field survey on March 13, 2000, do hereby state that under requirements of P.A. 74, Michigan P.A. of 1970, the corner points mentioned in lines 1 and 2 above were in conformance with regulations and rules therefore as required in the current manual of survey instructions of the United States Department of the Interior, Bureau of Land Management or by a decree of a Court of Law and / or that the corner points mentioned in lines 3, 4, and 5 above were in conformance with the rules of the Michigan Board of Land Surveyors or by a Decree of a Court of Law; established, re-established, monumented, recovered, found as expressed below.

NOTE: Not more than 2 corners, all in the same town and range, may be recorded on this certificate.

	A	B	C	D	E	F	G	H	I	J	K	L	M
1													
2	6		5		4		3		2		1		
3													
4	7		8		9		10		11		12		
5													
6	18		17		16		15		14		13		
7													
8	19		20		21		22		23		24		
9													
10	30		29		28		27		26		25		
11													
12	31		32		33		34		35		36		
13													

**A. Description of original monument and accessories and / or subsequent restoration:**

Original survey by William Ives in 1848.  
Original Corner: Wood post set at 40 chains  
Original Bearing Trees: 16" White Pine N 74° W 11 Links  
12" Yellow Birch S 09° E 16 Links

**B. Description of corner evidence found and / or method applied in restoring or re-establishing corner:**

No corner evidence found.  
I set a 30" aluminum Bernsten monument at the intersection of an extension of Bergslien Road from the East and an ancient fence line running South to the Montreal River.

Record research on file.  
(see sketch on back)


**FIELD GROUP APPROVED**  
*Richard P. Decker* 5/24/00  
COUNTY BENSON

**C. Description of monument for corner and accessories established to perpetuate locating the position of the corner:**

I accepted the aluminum monument as monumenting the quarter corner common to Sections 13 and 14, from which I established the following witnesses:

14" Balsam	S 02° W	38.90 Feet
13" Balsam	S 22° W	20.55 Feet
12" Balsam	S 80° W	13.54 Feet
Power Pole	S 32° E	43.07 Feet # RIP 027
4' Steel rail with sign	S 18° W	0.90 Feet

Signed by *John R. Garske*  
Surveyor's Michigan License No. 28410  
FB # 213, page 120

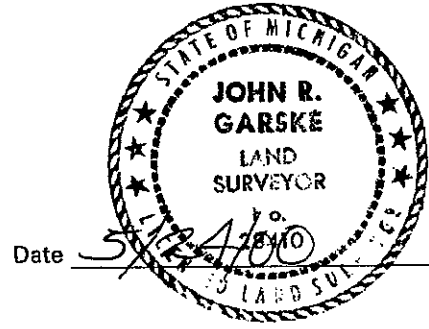

Date 5/24/00

Quarter Corner common to Sections 13 & 14,  
T 46 N, R 47 W.

SURVEY &  
REMONUMENTATION

JAN 05 2001

SECTION



Scale: 1" = 300'

