

SURVEY &
REMONUMENTATION

LAND CORNER MONUMENTS


JAN 20 1999

T. 46 N., R. 47 W.

SECTION

ERWIN TOWNSHIP

State
Index

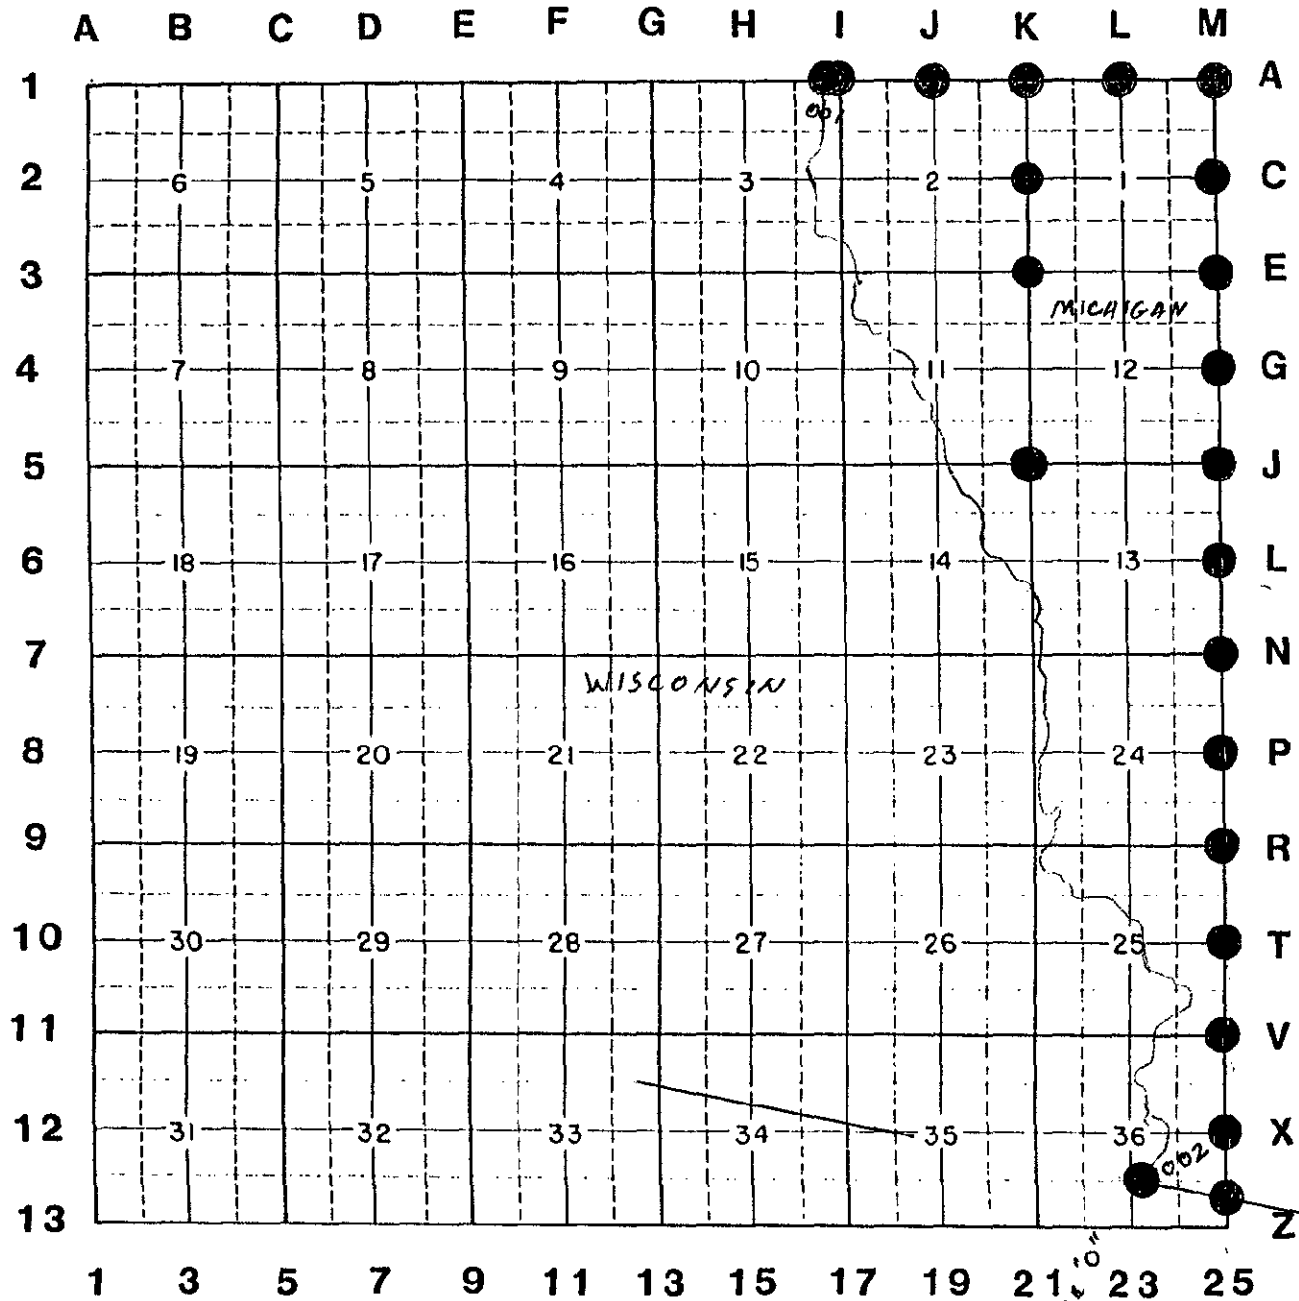

AS OF 12/31/98

LEGEND

- GLO Corners researched
- ⊙ GLO Corners monumented, not approved
- ⊗ GLO Corners approved
- GLO Corners approved & reported to State

T. 46 N., R. 47 W.