

**SURVEY & REMONUMENTATION**

APR 05 1996

**COMMISSION**

**LAND CORNER RECORDATION CERTIFICATE**  
**Filing Requirement of Act 74, Mich. P.A. 1970**

Register's Office }  
 Gogebic County } ss.

For corners in Ontonagon  
 (County)  
Gogebic

Located In: Corner Code #

1. Public Land Survey	*	T 48N	R 42W	A-13
Gogebic		T 47N	R 42W	A-1
* ONTONAGON COUNTY	*	T 48	R 43	M-13
		T 47	R 43	M-1
2. Property Controlling in Section	S	T	R	
3. Miscellaneous Property in Section	S	T	R	


Received for record the  
15<sup>TH</sup> day of DECEMBER  
 A. D. 1995 at 10:15 o'clock  
A m., and recorded in  
 Liber 5 of CORNERS  
 on page 307.

*Ramona Collins Deputy*  
 Register of Deeds

Register of Deeds Stamp & File Number

4. Lot No. \_\_\_\_\_, Recorded Plat \_\_\_\_\_  
 5. Private Claims \_\_\_\_\_  
 Section corner common to Sections 1, 6, 31 and 36, T47-48N, R42-43W.

I, John R. Garske, in a field survey on October 19, 1995, do hereby certify that under requirements of P.A. 74, Michigan P.A. of 1970, the corner points mentioned in lines 1 and 2 above were in conformance with regulations and rules therefore as required in the current manual of survey instructions of the United States Department of the Interior, Bureau of Land Management or by a decree of a Court of Law and/or that the corner points mentioned in lines 3, 4 and 5 above were in conformance with the rules of the Michigan Board of Professional Surveyors or by a Decree of a Court of Law; established, re-established, monumented, re-monumented, recovered, found as expressed below:

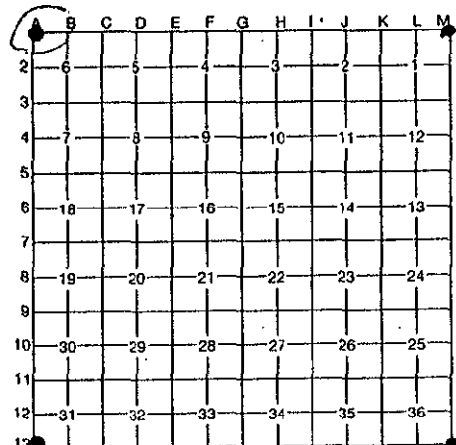

**NOTE: Not more than 4 corners, all in the same town and range, may be recorded on this certificate.**


A. **Description of original monument and accessories and/or subsequent restoration:**  
 - Original corner established by William Burt, U.S. Deputy Surveyor, on August 10, 1847. Original bearing trees:  
 9" black ash - N33°W - 12 links      9" elm - S14°E - 42 links  
 - On June 11, 1974, Donald D. Lappala, USFS Surveyor, RLS 12585 restored the corner from remains of the two original bearing trees. At the corner position he set a 2 1/2" I.D. x 5' concrete filled galvanized iron pipe, capped with a 3" circular bronze tablet which reads: T47-48N; R42-43W; S-1: S-6; S-31; S-36; RLS 12585, 1974, from which he established the following bearing trees:  
 7" Y. birch - N64°W - 31.0 feet  
 12" elm - S23°E - 29.9 feet  
 7" B. ash - N33°E - 16.8 feet

Corner recorded in L. USFS, P. 376.  
 B. **Description of corner evidence found and/or method applied in restoring or reestablishing corner:**  
 I found the monument and established new bearing trees set by Lappala as described above. I repainted the bearing trees and got new measurements to B.T.'s as noted below

Act 74 research on file with County Register of Deeds office.

C. **Description of monument for corner and accessories established to perpetuate locating the position of the corner:**  
 I used the monument set by Lappala and updated the corner according to state and county specifications as follows:  
 12" ash - N39°E - 16.68 feet (existing)  
 4" maple - N80°W - 4.17 feet  
 6" maple - S04°E - 16.47 feet  
 Sign post - S55°E - 1.60 feet

PEER GROUP APPROVED  
*Richard R. Decker* 12/14/95  
 COUNTY REPRESENTATIVE

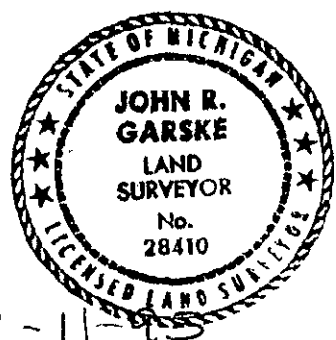

Signed by John R. Garske Date 12-11-95  
 Surveyor's Michigan License No. 28410