

SURVEY & REMONUMENTATION

JUN 29 1995

COMMISSION

map
COMP

LAND CORNER RECORDATION CERTIFICATE
Filing Requirement of Act 74, Mich. P.A. 1970

Register's Office }
Gogebic County } ss.

Received for record the
26TH day of JANUARY
A. D. 1995 at 10:55 o'clock
A m., and recorded in
Liber 5 of CORNERS
on page 180.

Register of Deeds

Register of Deeds Stamp & File Number

For corners in Gogebic (County) Located In: Corner Code #

1. Public Land Survey Section 8 T 47N R 42W C-3
 T _____ R _____
 T _____ R _____
 T _____ R _____

2. Property Controlling in Section S _____ T _____ R _____
 S _____ T _____ R _____

3. Miscellaneous Property in Sec. S _____ T _____ R _____
 S _____ T _____ R _____

4. Lot No. _____, Recorded Plat _____

5. Private Claims _____
 Section corner 5, 6, 7 and 8, T47N, R42W

	A	B	C	D	E	F	G	H	I	J	K	L	M
2	6		5		4		3		2		1		
3													
4	7		8		9		10		11		12		
5													
6	18		17		16		15		14		13		
7													
8	19		20		21		22		23		24		
9													
10	30		29		28		27		26		25		
11													
12	31		32		33		34		35		36		

I, John R. Garske, in a field survey on November 3, 1994, do hereby certify that under requirements of P.A. 74, Michigan P.A. of 1970, the corner points mentioned in lines 1 and 2 above were in conformance with regulations and rules therefore as required in the current manual of survey instructions of the United States Department of the Interior, Bureau of Land Management or by a decree of a Court of Law and/or that the corner points mentioned in lines 3, 4 and 5 above were in conformance with the rules of the Michigan Board of Land Surveyors or by a Decree of a Court of Law; established, re-established, monumented, re-monumented, recovered, found as expressed below:

NOTE: Not more than 4 corners, all in the same town and range, may be recorded on this certificate.

A. Description of original monument and accessories and/or subsequent restoration:

Original survey by A. Merryweather, July 12, 1851. Set wood post at corner. Original bearing trees:

- 12" Y. birch - S50°W - 27 links
- 24" hemlock - N45°E - 37 links

1961 - Corner set by Neil Sperhake, RLS 7876. Set a 4" diameter aluminum cap on a 1 1/4" diameter pipe. Corner recorded Liber 1, page 279 by Don Lappala, RLS 12585, USFS Liber pg. E-5, March 4, 1975. (see reference below)

B. Description of corner evidence found and/or method applied in restoring or reestablishing corner:

I found the Sperhake (Kimberly-Clark Corporation) monument in good condition with his bearing trees, a 9" Hemlock - N60°W - 22.1 feet in good condition and a 14" hemlock - S18°W - 21.6 feet destroyed. Lappala's bearing trees are:

- 12" cedar - N45°E - 20.4 feet (good condition)
- 5" yellow birch - S79°E - 34.7 feet (good condition)
- 9" hemlock - S04°E - 14.3 feet (destroyed)

I updated the corner to county specs as noted below. County record research on file with Register of Deeds.

PEER GROUP


Approved

Richard P. Drach 1/25/95

C. Description of monument for corner and accessories established to perpetuate locating the position of the corner:

Found 4" diameter aluminum stamped capped on a 1 1/4" diameter pipe from which I established the following bearing trees and reference objects:

- 12" cedar - N44°E - 19.68 feet (existing)
- 7" Y. birch - S78°E - 34.82 feet (existing)
- 12" hemlock - N55°W - 22.11 feet
- 6' steel sign post - S27°W - 3.38 feet

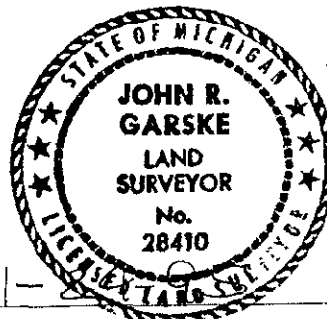

Signed by John R. Garske Date _____
 Surveyor's Michigan License No. 28410