

LAND CORNER RECORDATION CERTIFICATE

FILING REQUIREMENT OF ACT 74, MICH. P.A.1970

Gogebic County

Register's Office }
Gogebic County } ss.

FOR CORNERS OF--	LOCATED IN--	CORNER CODE NUMBER
1. PUBLIC LAND SURVEY	T. 47 N. X., R. 42 W.	C-11
2. PROPERTY CONTROLLING IN SECTION	T. _____ N. S., R. _____ E. W.	
3. MISCELLANEOUS PROPERTY IN SECTION	T. _____ N. S., R. _____ E. W.	
4. LOT NO. _____, RECORDED PLAT _____		
5. PRIVATE CLAIMS _____		

Received for record the
4th day of JANUARY
A. D. 1993 at 2:00 o'clock
9 m., and recorded in
Liber 4 of CONCORD
on page 201
Richard L. Drahn
Register of Deeds

REGISTER OF DEEDS STAMP AND FILING NUMBER

PEER GROUP

Approved Richard L. Drahn
1/20/94

Section Corner 29, 30, 31 & 32; T.47N., R.42W.

I, Richard L. Drahn do hereby certify that under requirements of P.A. 74, Michigan P.A. of 1970, the corner points mentioned in lines 1 and 2 above (identified with circles on index code diagram - over) were, in a field survey on October 15 1992, established, re-established, monumented, re-monumented, recovered or restored as expressed below and in conformance with regulations and rules therefore as required in the current manual of survey instructions of the United States Department of the Interior, Bureau of Land Management or by a decree of a court of law. Furthermore, that the corner points mentioned in lines 3, 4 and 5 above were, in a field survey on _____ 19____, found, recovered, restored, established or re-established as expressed below and in conformance with the rules of the Michigan State Board of Registration for Land Surveyors or, by a Decree of a Court of law:

A. Description of original monument and accessories and/or subsequent restoration:

Original corner established by Algernon Merryweather, U.S. Deputy Surveyor, on July 7, 1851; original bearing trees:

Birch	8"	S.47 ⁰ W.	16 links	(10.56 feet)
Sugar Maple	16"	N.80 ⁰ E.	11 links	(7.26 feet)

11.40 chains South of corner, original field notes referenced a 40" Yellow Birch line tree.

B. Description of corner evidence found and/or method applied in restoring or re-establishing corner:

Corner position restored by proportionate measurement from section corner South, through remains of 40" Yellow Birch line, (now a 40-50" Yellow Birch stump) to corner location. At a location S.47⁰W., 10.6 feet, I recovered a large windthrown stump hole. At N.80⁰E., 7.3 feet, I recovered fragments of Sugar Maple wood in several large root holes. Possible G.L.O. Witness Tree; 20" Sugar Maple with deep overgrown blaze S.09⁰E., 23.6 feet.

C. Description of monument for corner and accessories established to perpetuate locating the position of the corner:

At the corner position I set a standard 2½" diameter by 30" long split base aluminum monument with a 3" cast aluminum cap, stamped to read: T.47N., R.42W.; S-29, S-30, S-31, S-32; 1992; R.L.S. 21564; from which I have established the following new blazed and scribed bearing trees:

13"	Hemlock	N.88 ⁰ W.	27.68 feet
9"	Hemlock	N.75 ⁰ E.	40.40 feet
12"	Hemlock	S.20 ⁰ W.	25.35 feet
6'	Steel rail	N.32 ⁰ W.	2.4 feet

SIGNED BY _____ DATE _____


SURVEYOR'S MICHIGAN REGISTRATION NO. _____

FOR STATE AND UNITED STATES AGENCIES:

SIGNED BY _____ DATE _____

APPROVED AND SIGNED BY Richard L. Drahn DATE 12-28-92

U.S.F.S. V-5

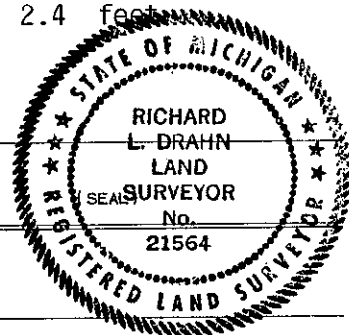

SURVEYOR'S MICHIGAN REGISTRATION NO. 21564