

LAND CORNER RECORDATION CERTIFICATE

FILING REQUIREMENT OF ACT 74, MICH. P.A.1970

Gogebic County

Register's Office }
Gogebic County } ss.

FOR CORNERS OF--:	LOCATED IN--:	CORNER CODE NUMBER
1. PUBLIC LAND SURVEY _____	T. 47 N. 8. R. 42 W.	C-12
2. PROPERTY CONTROLLING IN SECTION _____	T. _____ N. S. R. _____ E. W.	
3. MISCELLANEOUS PROPERTY IN SECTION _____	T. _____ N. S. R. _____ E. W.	
4. LOT NO. _____, RECORDED PLAT _____	PEER GROUP <i>Richard L. Drahn</i> 1/20/94	
5. PRIVATE CLAIMS _____		

Received for record the
4th day of JANUARY
A. D. 1992 at 2:00 o'clock
1st m., and recorded in
Liber 4 of CORNER
on page 202
Approved Richard L. Drahn
Register of Deeds

REGISTER OF DEEDS STAMP AND FILING NUMBER

I, Richard L. Drahn do hereby certify that under requirements of P.A. 74, Michigan P.A. of 1970, the corner points mentioned in lines 1 and 2 above (identified with circles on index code diagram—over) were, in a field survey on October 15 1992, established, re-established, monumented, re-monumented, recovered or restored as expressed below and in conformance with regulations and rules therefore as required in the current manual of survey instructions of the United States Department of the Interior, Bureau of Land Management or by a decree of a court of law. Furthermore, that the corner points mentioned in lines 3, 4 and 5 above were, in a field survey on _____ 19____, found, recovered, restored, established or re-established as expressed below and in conformance with the rules of the Michigan State Board of Registration for Land Surveyors or, by a Decree of a Court of law:

A. Description of original monument and accessories and/or subsequent restoration:
Original corner established by Algernon Merryweather, U.S. Deputy Surveyor, on July 7, 1851; original bearing trees:

Balsam	12"	S.22°E.	4 links	(2.64 feet)
Balsam	9"	N.27°W.	26 links	(17.16 feet)

B. Description of corner evidence found and/or method applied in restoring or re-establishing corner:
No evidence of original corner, bearing trees or subsequent corner restoration.
Corner position re-established by proportionate methods between corners
 $\frac{1}{2}$ mile North and South.

C. Description of monument for corner and accessories established to perpetuate locating the position of the corner:
At the corner position I set a standard 2½" diameter by 30" long split base aluminum monument with a 3" cast aluminum cap, stamped to read: T.47N., R.42W.; ¼; S-31, S-32; 1992; R.L.S. 21564; from which I have established the following new blazed and scribed bearing trees:

6"	Sugar Maple	N.42°W.	36.84 feet
5"	Red Maple	N.46°E.	35.86 feet
11"	Cedar	S.10°W.	19.70 feet
6"	Steel rail	N.73°W.	1.9 feet

SIGNED BY _____ DATE _____


SURVEYOR'S MICHIGAN REGISTRATION NO. _____

FOR STATE AND UNITED STATES AGENCIES:

SIGNED BY _____ DATE _____

APPROVED AND SIGNED BY Richard L. Drahn DATE 12-28-92

U.S.F.S. X-5

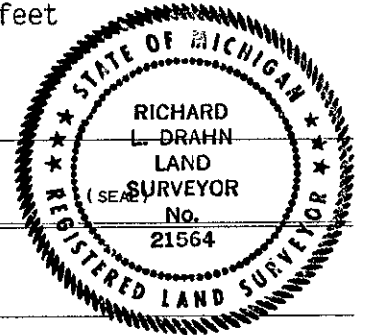

SURVEYOR'S MICHIGAN REGISTRATION NO. 21564