

LAND CORNER RECORDATION CERTIFICATE

FILING REQUIREMENT OF ACT 74, MICH. P.A.1970

Gogebic County

FOR CORNERS OF --	LOCATED IN --	CORNER CODE NUMBER
1. PUBLIC LAND SURVEY _____	T. 47 N. R. 42 W.	F-11
2. PROPERTY CONTROLLING IN SECTION _____	T. _____ N. S. R. _____ E. W.	_____
3. MISCELLANEOUS PROPERTY IN SECTION _____	T. _____ N. S. R. _____ E. W.	_____
4. LOT NO. _____, RECORDED PLAT _____	PEER GROUP Approved	
5. PRIVATE CLAIMS _____	<i>Richard L. Drahn 1/20/94</i>	
Quarter corner 28 & 33; T.47N., R.42W.		

Register's Office }
Gogebic County } ss.

Received for record the
4TH day of JANUARY
A. D. 1993 at 2:10 o'clock
P m., and recorded in
Liber 4 of CORNERS
on page 205
Richard L. Drahn Jr
Register of Deeds

REGISTER OF DEEDS STAMP AND FILING NUMBER

I, Richard L. Drahn do hereby certify that under requirements of P.A. 74, Michigan P.A. of 1970, the corner points mentioned in lines 1 and 2 above (identified with circles on index code diagram - over) were, in a field survey on November 5 1992, established, re-established, monumented, re-monumented, recovered or restored as expressed below and in conformance with regulations and rules therefore as required in the current manual of survey instructions of the United States Department of the Interior, Bureau of Land Management or by a decree of a court of law. Furthermore, that the corner points mentioned in lines 3, 4 and 5 above were, in a field survey on _____ 19____, found, recovered, restored, established or re-established as expressed below and in conformance with the rules of the Michigan State Board of Registration for Land Surveyors or, by a Decree of a Court of law:

A. Description of original monument and accessories and/or subsequent restoration:

Original corner established by Algernon Merryweather, U.S. Deputy Surveyor, on July 5, 1851. Original bearing trees:

Sugar Maple	9"	S.50 ⁰ E.	18 links	(11.88 feet)
Hemlock	20"	N.46 ⁰ W.	40 links	(26.40 feet)

B. Description of corner evidence found and/or method applied in restoring or re-establishing corner:

Restored corner position at record bearing and distance from the two original bearing trees. The first is a deep stump hole with fragments of badly decayed sugar maple wood. The second one is now a very large stump hole with fragments of hemlock bark still present.

C. Description of monument for corner and accessories established to perpetuate locating the position of the corner:

At the corner position I set a standard 2½" diameter by 30" long split base aluminum monument with a 3" cast aluminum cap, stamped to read: T.47N., R.42W.; ¼; S-28, S-33; 1992; R.L.S. 21564; from which I have established the following new blazed and scribed bearing trees:

14" Yellow Birch	N.38 ⁰ W.	31.97 feet
7" Sugar Maple	N.69 ⁰ E.	20.37 feet
9" White Ash	S.56 ⁰ W.	19.41 feet
6' Steel rail	S.46 ⁰ E.	1.5 feet

SIGNED BY _____ DATE _____


SURVEYOR'S MICHIGAN REGISTRATION NO. _____

FOR STATE AND UNITED STATES AGENCIES:

SIGNED BY _____ DATE _____

APPROVED AND SIGNED BY Richard L. Drahn DATE 12-28-92
MICHIGAN REGISTERED LAND SURVEYOR

U.S.F.S. V-11

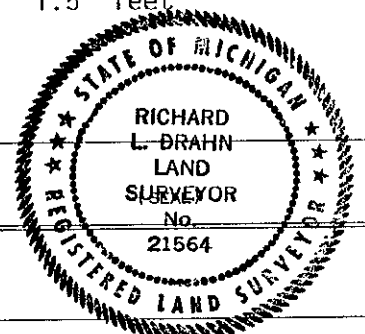

SURVEYOR'S MICHIGAN REGISTRATION NO. 21564