

SURVEY &
 REMONUMENTATION
 COMMISSION
 APR 07 1995

LAND CORNER RECORDATION CERTIFICATE
 Filing Requirement of Act 74, Mich. P.A. 1970

Register's Office } ss.
 Gogebic County }

Received for record the
21st day of October
 A. D. 1994 at 11:15 o'clock
A m., and recorded in
 Liber 5 of GOGBIC
 on page 146
Ramona Collins Deputy
 Register of Deeds

Register of Deeds Stamp & File Number

For corners in Gogebic (County)

Located In: Corner Code #

1. Public Land Survey Section 27	T <u>47N</u> R <u>42W</u>	<u>G-10</u>
	T _____ R _____	_____
	T _____ R _____	_____
	T _____ R _____	_____
2. Property Controlling in Section	S _____ T _____ R _____	_____
	S _____ T _____ R _____	_____
3. Miscellaneous Property in Sec.	S _____ T _____ R _____	_____
	S _____ T _____ R _____	_____

4. Lot No. _____, Recorded Plat _____

5. Private Claims _____

	A	B	C	D	E	F	G	H	I	J	K	L	M
2	6		5		4		3		2		1		
3													
4	7		8		9		10		11		12		
5													
6	18		17		16		15		14		13		
7													
8	19		20		21		22		23		24		
9													
10	30		29		28		27		26		25		
11													
12	31		32		33		34		35		36		
13													

1/4 cor. comm. to sec's. 27 & 28

I, John P. Goss, in a field survey on September 30, 1994, do hereby certify that under requirements of P.A. 74, Michigan P.A. of 1970, the corner points mentioned in lines 1 and 2 above were in conformance with regulations and rules therefore as required in the current manual of survey instructions of the United States Department of the Interior, Bureau of Land Management or by a decree of a Court of Law and/or that the corner points mentioned in lines 3, 4 and 5 above were in conformance with the rules of the Michigan Board of Land Surveyors or by a Decree of a Court of Law; established, re-established, monumented, re-monumented, recovered, found as expressed below:

NOTE: Not more than 4 corners, all in the same town and range, may be recorded on this certificate.


A. Description of original monument and accessories and/or subsequent restoration:
 Original survey by Algemon Merryweather in 1851. Set post. Original bearing trees.
 Hemlock 12"- N20°W- 18 links; Hemlock 6"- S30°E- 24 links.

Corner was relocated and used in 1931 for part of unrecorded plat of Koronski Plat of Lake Gogebic.

B. Description of corner evidence found and/or method applied in restoring or reestablishing corner:
 Railroad Spike was set in 1977 using corners from Koronski unrecorded plat. Because no original evidence of corner location could be found road activity in area.

Act 74 research on file with the County Register of Deeds Office.

PEER GROUP Approved
Richard P. Dredman 10/12/94

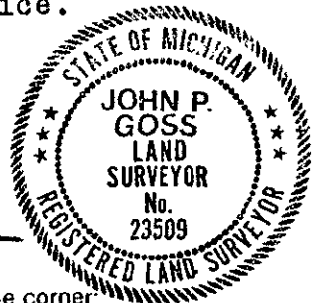

C. Description of monument for corner and accessories established to perpetuate locating the position of the corner:
 A railroad spike marks the corner position from which I established the following bearing objects.

I set reference monuments #1 and #2 consisting of 2 1/2" diameter x 30" long aluminum pipe with 3/4" diameter cap stamped to note the corner position as follows:

- R.M. #1 N72°E - 31.70' - steel sign post- 1.02'
- R.M. #2 N59°W - 25.95' - steel sign post- 1.25'
- D.H. nail & tag in 5" Maple S25°E - 76.17'
- D.H. nail & tag in P.Pole S59°W - 67.03'

Signed by John P. Goss Date 9-30-94
 Surveyor's Michigan License No. P.S. 23509