

LAND CORNER RECORDATION CERTIFICATE

FILING REQUIREMENT OF ACT 74, MICH. P.A.1970

Gogebic County

FOR CORNERS OF--	LOCATED IN--	CORNER CODE NUMBER
1. PUBLIC LAND SURVEY _____	T. <u>47</u> ^{N.} / S. , R. <u>42</u> ^{K.} / W.	<u>G-11</u>
2. PROPERTY CONTROLLING IN SECTION _____	, T. _____, ^{N.} / S. , R. _____, ^{E.} / W.	
3. MISCELLANEOUS PROPERTY IN SECTION _____	, T. _____, ^{N.} / S. , R. _____, ^{E.} / W.	
4. LOT NO. _____, RECORDED PLAT _____	PEER GROUP <i>Richard L. Drahn</i> 1/20/94	
5. PRIVATE CLAIMS _____	Section Corner 27, 28, 33 & 34; T.47N., R.42W.	

Register's Office }
Gogebic County } ss.

Received for record the
4TH day of JANUARY
A. D. 1993 at 2:10 o'clock
P m., and recorded in
Liber 4 of CORNERS
Approved on page 206
Richard J. Brown
Register of Deeds

REGISTER OF DEEDS STAMP AND FILING NUMBER

I, Richard L. Drahn do hereby certify that under requirements of P.A. 74, Michigan P.A. of 1970, the corner points mentioned in lines 1 and 2 above (identified with circles on index code diagram—over) were, in a field survey on November 9 1992, established, re-established, monumented, re-monumented, recovered or restored as expressed below and in conformance with regulations and rules therefore as required in the current manual of survey instructions of the United States Department of the Interior, Bureau of Land Management or by a decree of a court of law. Furthermore, that the corner points mentioned in lines 3, 4 and 5 above were, in a field survey on _____ 19____, found, recovered, restored, established or re-established as expressed below and in conformance with the rules of the Michigan State Board of Registration for Land Surveyors or, by a Decree of a Court of law:

- A. Description of original monument and accessories and/or subsequent restoration:
- | | | | | |
|---------|-----|----------------------|----------|--------------|
| Hemlock | 18" | S.55 ⁰ W. | 33 links | (21.78 feet) |
| Elm | 24" | N.65 ⁰ E. | 33 links | (21.78 feet) |
- Michigan Dept. of Transportation, (M.D.O.T.), after a survey in 1959, set a monumentation box at this corner location.
In 1979, Jack Goss, Registered Land Surveyor, referenced the following bearing objects:
6" Elm, S.37E., 68.55 ft.; power pole S.75⁰E., 34.96 ft.; 4" F.S. post, S.85E., 38.96 ft.; 7" Maple, N.55⁰E., 41.80 ft.
- B. Description of corner evidence found and/or method applied in restoring or re-establishing corner:
No evidence found of original corner or bearing trees. Recovered M.D.O.T. monumentation box in M-64. Recovered the Power Pole referenced by Jack Goss at S.69⁰E., 34.93 feet. Distance west to recovered original $\frac{1}{4}$ corner of 28 & 33 is consistent with the field notes of the original Government survey.

- C. Description of monument for corner and accessories established to perpetuate locating the position of the corner:
From the above described Monumentation Box in M-64, I established the following bearing trees and reference objects:
A standard Reference Monument stamped to indicate actual corner location bears:
West 42.55 feet.
- | | | | |
|-----|--------------|----------------------|------------|
| 10" | Sugar Maple | N.87 ⁰ W. | 61.25 feet |
| | Power Pole | S.69 ⁰ E. | 34.93 feet |
| 5" | Yellow Birch | S.58 ⁰ W. | 70.50 feet |
| 6' | Steel rail | West | 40.85 feet |

SIGNED BY _____ DATE _____


SURVEYOR'S MICHIGAN REGISTRATION NO. _____

FOR STATE AND UNITED STATES AGENCIES:

SIGNED BY _____ DATE _____

APPROVED AND SIGNED BY Richard L. Drahn DATE 12-28-92

U.S.F.S. V-13

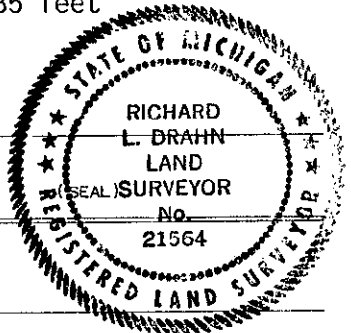

SURVEYOR'S MICHIGAN REGISTRATION NO. 21564