

SURVEY & REMONUMENTATION
APR 07 1995
COMMISSION

LAND CORNER RECORDATION CERTIFICATE
Filing Requirement of Act 74, Mich. P.A. 1970

For corners in
Gogebic
 (County)

Located In: _____ Corner Code # _____

1. Public Land Survey Section 10	T <u>47N</u> R <u>42W</u>	<u>I-4</u>
	T _____ R _____	_____
	T _____ R _____	_____
	T _____ R _____	_____
2. Property Controlling in Section	S _____ T _____ R _____	_____
	S _____ T _____ R _____	_____
3. Miscellaneous Property in Sec.	S _____ T _____ R _____	_____
	S _____ T _____ R _____	_____

Register's Office }
 Gogebic County } ss.

Received for record the
21ST day of OCTOBER
 A. D. 1994 at 11:15 o'clock
A m., and recorded in
 Liber 5 of CORNERS
 on page 142
Ramona Collins, Deputy
 Register of Deeds

Register of Deeds Stamp & File Number

4. Lot No. _____, Recorded Plat _____

5. Private Claims _____

1/4 cor. comm. to sec's. 10 & 11

I, John P. Goss, in a field survey on September 24, 1994, do hereby certify that under requirements of P.A. 74, Michigan P.A. of 1970, the corner points mentioned in lines 1 and 2 above were in conformance with regulations and rules therefore as required in the current manual of survey instructions of the United States Department of the Interior, Bureau of Land Management or by a decree of a Court of Law and/or that the corner points mentioned in lines 3, 4 and 5 above were in conformance with the rules of the Michigan Board of Land Surveyors or by a Decree of a Court of Law; established, re-established, monumented, re-monumented, recovered, found as expressed below:

NOTE: Not more than 4 corners, all in the same town and range, may be recorded on this certificate.

A	B	C	D	E	F	G	H	I	J	K	L	M
2	6	5	4	3	2	1						
3												
4	7	8	9	10	11	12						
5												
6	18	17	16	15	14	13						
7												
8	19	20	21	22	23	24						
9												
10	30	29	28	27	26	25						
11												
12	31	32	33	34	35	36						
13												

A. Description of original monument and accessories and/or subsequent restoration:

Original survey by Algemon Merryweather in 1848. Set a post.

Original bearing trees.

Sugar 10" N70°E 17 links
 Sugar 10" S35°W 32 links

B. Description of corner evidence found and/or method applied in restoring or reestablishing corner:

Drill rod found in place with metal sign in nearby tree in 1970. In 1970 this drill rod was used by Gogebic County Road Commission in survey of the East Shore of Lake Gogebic Road and has been used by various surveyor's in the area. Therefore accepted as best location for 1/4 Section Corner.

Act 74 research on file with the County Register of Deeds Office.

PEER GROUP


Approved

Richard L. Deal 10/12/94

C. Description of monument for corner and accessories established to perpetuate locating the position of the corner:

I set a 2 1/2" x 30" long aluminum pipe with a 3 1/4" aluminum cap stamped: 1/4, S-10, S-11, T.47 N., R.42 W., 1994, P.S. 23509, over the drill rod that I found. I established the following bearing trees and reference objects.

D.H. nail & tag in 6" Ash	S15°E	15.28'
D.H. nail & tag in 6" Ash	S85°W	40.37'
D.H. nail & tag in 7" Maple	N09°W	21.94'
Nail in 12" Cedar	N18°E	15.52'
Steel Sign Post	S70°E	0.93'

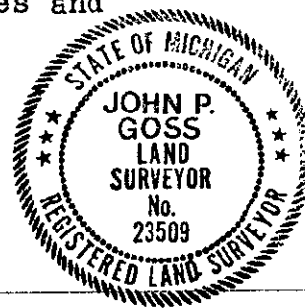

Signed by John P. Goss

Date 9-25-94

Surveyor's Michigan License No. P.S. 23509