

**SURVEY & REMONUMENTATION**

JUN 29 1995

COMMISSION

MAP  
COMP

**LAND CORNER RECORDATION CERTIFICATE**  
Filing Requirement of Act 74, Mich. P.A. 1970

Register's Office }  
Gogebic County } ss.

For corners in  
Gogebic  
(County)

Located In: Corner Code #

- |                                    |                           |            |
|------------------------------------|---------------------------|------------|
| 1. Public Land Survey              | T <u>47N</u> R <u>42W</u> | <u>J-9</u> |
|                                    | T _____ R _____           | _____      |
|                                    | T _____ R _____           | _____      |
|                                    | T _____ R _____           | _____      |
| 2. Property Controlling in Section | S _____ T _____ R _____   | _____      |
|                                    | S _____ T _____ R _____   | _____      |
| 3. Miscellaneous Property in Sec.  | S _____ T _____ R _____   | _____      |
|                                    | S _____ T _____ R _____   | _____      |

Received for record the  
26<sup>TH</sup> day of JANUARY  
A. D. 1995 at 10:53 o'clock  
4 m., and recorded in  
Liber 5 of CORNERS  
on page 181.

Register of Deeds  
Register of Deeds Stamp & File Number

4. Lot No. \_\_\_\_\_, Recorded Plat \_\_\_\_\_
5. Private Claims \_\_\_\_\_  
1/4 corner common to Sections 26 and 23, T47N, R42W

A	B	C	D	E	F	G	H	I	J	K	L	M
2	6	5	4	3	2	1						
3												
4	7	8	9	10	11	12						
5												
6	18	17	16	15	14	13						
7												
8	19	20	21	22	23	24						
9												
10	30	29	28	27	26	25						
11												
12	31	32	33	34	35	36						
13												

I, John R. Garske, in a field survey on November 3, 1994, do hereby certify that under requirements of P.A. 74, Michigan P.A. of 1970, the corner points mentioned in lines 1 and 2 above were in conformance with regulations and rules therefore as required in the current manual of survey instructions of the United States Department of the Interior, Bureau of Land Management or by a decree of a Court of Law and/or that the corner points mentioned in lines 3, 4 and 5 above were in conformance with the rules of the Michigan Board of Land Surveyors or by a Decree of a Court of Law; established, re-established, monumented, re-monumented, recovered, found as expressed below:

**NOTE: Not more than 4 corners, all in the same town and range, may be recorded on this certificate.**

A. Description of original monument and accessories and/or subsequent restoration:

Original survey by A. Merryweather, 1851. Set 1/4 post. Original bearing trees:  
Elm 26" - S50°W - 7 links  
Sugar 12" - N15°E - 24 links

1961 - Neil Sperhake, RLS 7876, surveyor for Kimberly Clark restored the corner and set a 4" diameter aluminum cap on a 1" diameter iron pipe at the corner. Bearing trees:  
12" maple - N15°W - 25.5 feet  
6" maple - S20°E - 21.6 feet

1969 - Don Lappala, RLS 12585 - Found Sperhake's corner in good condition and recorded it on 3/31/69, Liber 1, pg. 89. Bearing trees are same as above.

B. Description of corner evidence found and/or method applied in restoring or reestablishing corner:

On June 17, 1990 - I found the Sperhake and Lappala bearing trees but the corner monument was destroyed. I reset the monument with a 2 1/2" diameter x 30" long aluminum pipe with a stamped 3" diameter aluminum cap and established three new B.T.'s:

- 6" maple - S20°E - 21.55 feet
- 12" maple - N15°W - 25.45 feet
- 6" maple - S50°W - 20.14 feet

On November 3, 1994, I found the monument and bearing trees to be in good condition and I brought the corner up to county specs as noted below.

PEER GROUP


Approved

Richard P. Waha 1/25/95

C. Description of monument for corner and accessories established to perpetuate locating the position of the corner:

Found the 2 1/2" x 30" aluminum pipe with 3" aluminum cap stamped: 1/4 cor.; S-23; S-26; T47N, R42W; 1990; RLS 28410. Bearing trees and reference objects:

- 6" maple - S20°E - 21.55 feet (existing)
- 12" maple - N15°W - 25.45 feet (existing)
- 6" maple - S50°W - 20.14 feet (existing)
- Steel sign post - Due East - 1.59 feet

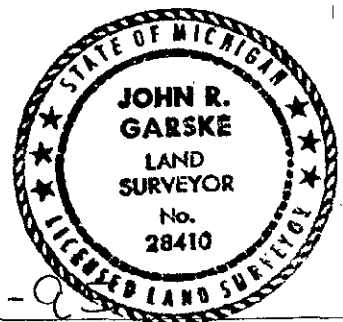

Signed by John R. Garske Date 1-24-95  
Surveyor's Michigan License No. 28410