

SURVEY &
REMONUMENTATION

1993

COMMISSION

LAND CORNER RECORDATION CERTIFICATE
Filing Requirement of Act 74, Mich. P.A. 1970

Register's Office }
Gogebic County } ss.

For corners in

Gogebic
(County)

Located In:

Corner Code =#

- | | | |
|-------------------------------|-------------------------|-------|
| 1. Public Land Survey Section | 35T 47N R 42W | J-11 |
| | T _____ R _____ | _____ |
| | T _____ R _____ | _____ |
| | T _____ R _____ | _____ |
| 2. Property Controlling | S _____ T _____ R _____ | _____ |
| in Section | S _____ T _____ R _____ | _____ |
| 3. Miscellaneous | S _____ T _____ R _____ | _____ |
| Property in Sec. | S _____ T _____ R _____ | _____ |

Received for record the
16th day of DECEMBER
A. D. 1993 at 2:25 o'clock
P m., and recorded in
Liber 4 of CORNERS
on page 296.

Betty Saari Deputy
Register of Deeds

Register of Deeds Stamp & File Number

4. Lot No. _____, Recorded Plat _____
5. Private Claims _____

One-quarter corner S-26 & S-35.

November 29 93

I, John R. Garske, in a field survey on _____, 19_____, do hereby certify that under requirements of P.A. 74, Michigan P.A. of 1970, the corner points mentioned in lines 1 and 2 above were in conformance with regulations and rules therefore as required in the current manual of survey instructions of the United States Department of the Interior, Bureau of Land Management or by a decree of a Court of Law and/or that the corner points mentioned in lines 3, 4 and 5 above were in conformance with the rules of the Michigan Board of Land Surveyors or by a Decree of a Court of Law; established, re-established, monumented, re-monumented, recovered, found as expressed below:

NOTE: Not more than 4 corners, all in the same town and range, may be recorded on this certificate.

	A	B	C	D	E	F	G	H	I	J	K	L	M
2	6	5	4	3	2								
3													
4	7	8	9	10	11	12							
5													
6	18	17	16	15	14	13							
7													
8	19	20	21	22	23	24							
9													
10	30	29	28	27	26	25							
11													
12	31	32	33	34	35	36							
13													

A. Description of original monument and accessories and/or subsequent restoration:

Survey by Algernon Meriweather, June 27, 1851, one-quarter post from which 5" hemlock bears S30°W, 22 links and a 28" sugar bears N50°E, 14 links. No original evidence found.


B. Description of corner evidence found and/or method applied in restoring or reestablishing corner:

Found 1" iron pipe with a bearing tree - A 6" sugar maple S55°E - 6.32 feet with a Champion tree tag. Accepted corner position due to its use in many surveys in area and longevity of pipe in a harmonious position. The corner was pointed out to us by Don Holmes, Champion forester, as existing for 30+ years. The pipe has been used in surveys in Sections 26 and 35 and in an unrecorded plat along the East Shore of Lake Gogebic. This position is also consistent with natural feature ties.

C. Description of monument for corner and accessories established to perpetuate locating the position of the corner:

Replaced 1" iron pipe with a standard Bernsten aluminum pipe with 3 1/2" aluminum cap stamped: County Remonumentation; T47N, R42W; S-26; S-35; 1/4 cor.; 1993; RLS 28410. Established the following bearing trees and reference objects:

- 6" sugar maple - feet
- 8" hemlock - S34°W - 19.46 feet
- 8" sugar maple - N45°W - 28.64 feet
- Steel sign post - N.E. ly - 1.81 feet

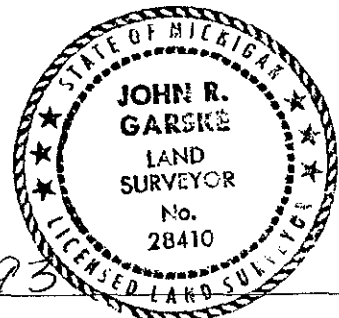

Signed by John R. Garske

Date 12-9-93

Surveyor's Michigan License No. 28410