

SURVEY &  
REMONUMENTATION

1993

COMMISSION

LAND CORNER RECORDATION CERTIFICATE  
Filing Requirement of Act 74, Mich. P.A. 1970

Register's Office }  
Gogebic County } ss.

Received for record the  
16<sup>th</sup> day of DECEMBER  
A. D. 1993 at 2:25 o'clock  
P m., and recorded in  
Liber 4 of CORNERS  
on page 297  
*Betty Laine Deputy*  
Register of Deeds

Register of Deeds Stamp & File Number

For corners in

Gogebic  
(County)

Located In:

Corner Code #

1. Public Land Survey Section 35 T 47N R 42W. J-13  
T \_\_\_\_\_ R \_\_\_\_\_  
T \_\_\_\_\_ R \_\_\_\_\_  
T \_\_\_\_\_ R \_\_\_\_\_
2. Property Controlling S \_\_\_\_\_ T \_\_\_\_\_ R \_\_\_\_\_  
in Section S \_\_\_\_\_ T \_\_\_\_\_ R \_\_\_\_\_
3. Miscellaneous S \_\_\_\_\_ T \_\_\_\_\_ R \_\_\_\_\_  
Property in Sec. S \_\_\_\_\_ T \_\_\_\_\_ R \_\_\_\_\_
4. Lot No. \_\_\_\_\_, Recorded Plat \_\_\_\_\_
5. Private Claims \_\_\_\_\_

One-quarter corner common to S-35 & S-2, T47N, R42W  
and T46N, R42W

November 4 93

I, John R. Garske, in a field survey on \_\_\_\_\_, 19\_\_\_\_\_, do hereby certify that under requirements of P.A. 74, Michigan P.A. of 1970, the corner points mentioned in lines 1 and 2 above were in conformance with regulations and rules therefore as required in the current manual of survey instructions of the United States Department of the Interior, Bureau of Land Management or by a decree of a Court of Law and/or that the corner points mentioned in lines 3, 4 and 5 above were in conformance with the rules of the Michigan Board of Land Surveyors or by a Decree of a Court of Law; established, re-established, monumented, re-monumented, recovered, found as expressed below:

**NOTE: Not more than 4 corners, all in the same town and range, may be recorded on this certificate.**

	A	B	C	D	E	F	G	H	I	J	K	L	M
2	6	5	4	3	2	1							
3													
4	7	8	9	10	11	12							
5													
6	18	17	16	15	14	13							
7													
8	19	20	21	22	23	24							
9													
10	30	29	28	27	26	25							
11													
12	31	32	33	34	35	36							
13													

A. Description of original monument and accessories and/or subsequent restoration:

Survey by William A. Burt, U.S.D.S., August 9, 1848. Set hemlock post from which a 8" cedar bears N50°E, 32 links and a 14" black ash bears N3°W, 42 links. No evidence found.


B. Description of corner evidence found and/or method applied in restoring or reestablishing corner:

Corner was set by single proportion between monumented corners, set on line and half the distance between said monumented corners.

C. Description of monument for corner and accessories established to perpetuate locating the position of the corner:

Set one section of 4' x 3/4" marsh rod with a 3 1/2" aluminum cap stamped: County Remonumentation; T47N, R42W; S-35; S-2; T46N; 1/4 cor.; 1993; RLS 28410. Established the following bearing trees and reference objects:

- 4" ash - N83°W - 13.64 feet
- 5" ash - N13°E - 16.30 feet
- 4" ash - S70°E - 17.07 feet
- Steel sign post - N26°W - 1.52 feet

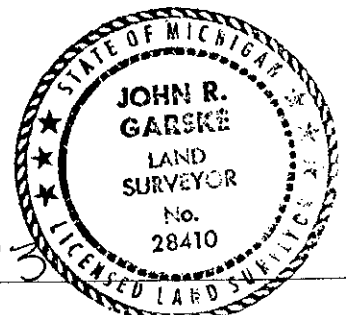

Signed by John R. Garske  
Surveyor's Michigan License No. 28410

Date 12/9/93