

SURVEY &  
REMONUMENTATION

1993

COMMISSION

LAND CORNER RECORDATION CERTIFICATE  
Filing Requirement of Act 74, Mich. P.A. 1970

Register's Office }  
Gogebic County } ss.

For corners in

Gogebic  
(County)

Located In:

Corner Code ##

- |                                    |      |              |            |             |
|------------------------------------|------|--------------|------------|-------------|
| 1. Public Land Survey Section      | 35 T | <u>47N</u> R | <u>42W</u> | <u>K-12</u> |
|                                    | T    | R            |            |             |
|                                    | T    | R            |            |             |
|                                    | T    | R            |            |             |
| 2. Property Controlling in Section | S    | T            | R          |             |
|                                    | S    | T            | R          |             |
| 3. Miscellaneous Property in Sec.  | S    | T            | R          |             |
|                                    | S    | T            | R          |             |

Received for record the  
16<sup>TH</sup> day of DECEMBER  
A. D. 1993 at 2:25 o'clock  
P m., and recorded in  
Liber 4 of CORNERS  
on page 298.  
*Betty Saari* Deputy  
Register of Deeds

Register of Deeds Stamp & File Number

4. Lot No. \_\_\_\_\_, Recorded Plat \_\_\_\_\_  
5. Private Claims \_\_\_\_\_

One-quarter corner S-35 & S36, T47N, R42W

I, John R. Garske, in a field survey on July 22, 1992, do hereby certify that under requirements of P.A. 74, Michigan P.A. of 1970, the corner points mentioned in lines 1 and 2 above were in conformance with regulations and rules therefore as required in the current manual of survey instructions of the United States Department of the Interior, Bureau of Land Management or by a decree of a Court of Law and/or that the corner points mentioned in lines 3, 4 and 5 above were in conformance with the rules of the Michigan Board of Land Surveyors or by a Decree of a Court of Law; established, re-established, monumented, re-monumented, recovered, found as expressed below:

	A	B	C	D	E	F	G	H	I	J	K	L	M
2	6	5	4	3	2	1							
3													
4	7	8	9	10	11	12							
5													
6	18	17	16	15	14	13							
7													
8	19	20	21	22	23	24							
9													
10	30	29	28	27	26	25							
11													
12	31	32	33	34	35	36							
13													

NOTE: Not more than 4 corners, all in the same town and range, may be recorded on this certificate.

A. Description of original monument and accessories and/or subsequent restoration:

Survey by Algemon Meriweather, June 26, 1851. Set one-quarter post from which a 6" hemlock bears south, 8 links and a 12" black ash bears N35W, 17 links.


B. Description of corner evidence found and/or method applied in restoring or reestablishing corner:

Found wooden post at corner location as noted to me by Champion Timberlands Forester, Don Holmes. Found remains of hemlock bearing tree at record bearing and distance from post. I accepted the wooden post as marking the true one-quarter corner knowing that it has existed for over 30 years at this location and was used in a previous survey of unknown origin in the subdivision of Section 35.

C. Description of monument for corner and accessories established to perpetuate locating the position of the corner:

Set standard Bernsten 30" long x 2 1/2" aluminum monument with 3 1/2" diameter aluminum cap stamped: T47N, R42W; 1/4 cor.; S-35; S-36; RLS 28410. Established the following bearing trees and reference objects:

- 8" maple - N35°E - 21.10 feet
- 4" maple - N70°W - 18.27 feet
- 6" maple - S25°W - 13.38 feet
- Steel sign post - SE'ly - 2.00 feet

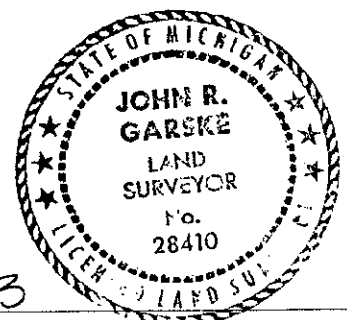

Signed by John R. Garske  
Surveyor's Michigan License No. 28410

Date 12/9/93