SURVEY &
REMONUMENTATION

APR 0 5 1996

COMMISSION

LAND CORNER RECORDATION CERTIFICATE
Filing Requirement of Act 74, Mich. P.A. 1970

Register's Office
Gogebic County } ss.

Received for record the 12th day of APRIL A. D. 1995 at 2:00 o'clock P m., and recorded in Liber 5 of Corners on page 249

Ramona Collins, Deputy
Register of Deeds

Register of Deeds Stamp & File Number

For corners in Gogebic & Ontonagon (County)

	Located In:	Corner Code #
1. Public Land Survey ONTONAGON	~~T48N R 42W~~	~~BC- 13~~
	T47N R 42W	BC- 1
	T ___ R ___	1.003
	T ___ R ___	
2. Property Controlling	S ___ T ___ R ___	Other #3
in Section	S ___ T ___ R ___	
3. Miscellaneous	S ___ T ___ R ___	
Property in Sec.	S ___ T ___ R ___	

4. Lot No. _____, Recorded Plat _____
5. Private Claims _____

M.C. Cor. comm to Sec. 6, T.47 N., R.42 W., and Sec. 31, T.48 N., R.42 W.

I, John P. Goss, in a field survey on April 3, 19 95, do hereby certify that under requirements of P.A. 74, Michigan P.A. of 1970, the corner points mentioned in lines 1 and 2 above were in conformance with regulations and rules therefore as required in the current manual of survey instructions of the United States Department of the Interior, Bureau of Land Management or by a decree of a Court of Law and/or that the corner points mentioned in lines 3, 4 and 5 above were in conformance with the rules of the Michigan Board of Land Surveyors or by a Decree of a Court of Law; established, re-established, monumented, re-monumented, recovered, found as expressed below:

NOTE: Not more than 4 corners, all in the same town and range, may be recorded on this certificate.

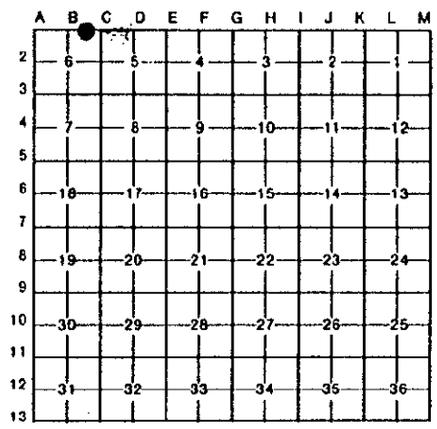

A. Description of original monument and accessories and/or subsequent restoration:

Original Survey by Wm. A. Burt on August 10, 1848. Set a Cedar Post. Original Bearing Trees: Cedar 9"- S 42° W- 13 links; Y. Birch 10"- N 72°W - 17 links.

John P. Goss in 1983 using MDOT witnesses found a 1 inch iron pin and recorded this corner in Liber 2 pages 308 and 309 of Gogebic County Land Corners: 6" Cedar- S 45°W- 8.78'; 8" Cedar- S 40°W-16.87'; 6" Cedar- N 65°W- 11.20'.

B. Description of corner evidence found and/or method applied in restoring or reestablishing corner:

I found the 1 inch iron pin marking the corner position and it was bened but closes to the witnesses in John P. Goss certificate. I updated the corner monument and accessories as noted below to state and county specification.

Act 74 research on file with the County Register of Deeds Office.

PEER GROUP APPROVED
Richard R Dreden 4/6/95
COUNTY REPRESENTATIVE

C. Description of monument for corner and accessories established to perpetuate locating the position of the corner:

Set a 3/4" iron Pin next to the bended 1" iron pin with a 3 1/4" Aluminum cap on the 3/4" iron pin stamped : County Remonumentation; M.C. S-6, S-31, T.48 N.; T.47 N.; R.42 W.; 1995; P.S. 23509. I established the following bearing trees and reference objects.

8" Cedar	S 45° W	8.78'
9" Cedar	N 65° W	16.20'
14" Cedar	S 15° E	15.01'
Steel Sign Post	Due W.	4.51'

STATE OF MICHIGAN
JOHN P. GOSS
LAND SURVEYOR
No. 23509
REGISTERED LAND SURVEYOR

Signed by John P Goss Date April 3, 1995

Surveyor's Michigan License No. P.S. 23509

FORM APPROVED BY MICHIGAN STATE BOARD OF LAND SURVEYORS, JAN. 28, 1971
REVISED MAY 14, 1975
REVISED JAN. 1983