

**SURVEY & REMONUMENTATION**

AUG 6 8 1997

**LAND CORNER RECORDATION CERTIFICATE**  
 Filing Requirement of Act 74, Mich. P.A. 1970

Register's Office }  
 Gogebic County } ss.

For corners in

Gogebic

(County)

Located in:

Corner Code #

- |                                    |                      |      |
|------------------------------------|----------------------|------|
| 1. Public Land Survey              | Section 3 T47N R 42W | II-3 |
|                                    | T ___ R ___          | ___  |
|                                    | T ___ R ___          | ___  |
|                                    | T ___ R ___          | ___  |
| 2. Property Controlling in Section | S ___ T ___ R ___    | ___  |
|                                    | S ___ T ___ R ___    | ___  |
| 3. Miscellaneous Property in Sec.  | S ___ T ___ R ___    | ___  |
|                                    | S ___ T ___ R ___    | ___  |

Received for record the  
11<sup>TH</sup> day of JUNE  
 A. D. 1997 at 10:35 o'clock  
A m., and recorded in  
 Liber 6 of CORNERS

on page 133  
*Colleen M. Kitch Deputy*  
 Register of Deeds

Register of Deeds Stamp & File Number

4. Lot No. \_\_\_\_\_, Recorded Plat \_\_\_\_\_  
 5. Private Claims \_\_\_\_\_

One-quarter corner S-3 & S-10, T47N, R42W.

I, John R. Garske, in a field survey on April 29, 1997 do hereby state that under requirements of P.A. 74, Michigan P.A. of 1970, the corner points mentioned in lines 1 and 2 above were in conformance with regulations and rules therefore as required in the current manual of survey instructions of the United States Department of the Interior, Bureau of Land Management or by a decree of a Court of Law and for that the corner points mentioned in lines 3, 4 and 5 above were in conformance with the rules of the Michigan Board of Land Surveyors or by a Decree of a Court of Law; established, re-established, monumented, recovered, found as expressed below:

NOTE: Not more than 2 corners, all in the same town and range, may be recorded on this certificate.

	A	B	C	D	E	F	G	H	I	J	K	L	M
1													
2	6		5		4		3		2		1		
3								●					
4	7		8		9		10		11		12		
5													
6	18		17		16		15		14		13		
7													
8	19		20		21		22		23		24		
9													
10	30		29		28		27		26		25		
11													
12	31		32		33		34		35		36		
13													

A. Description of original monument and accessories and/or subsequent restoration:

Survey by Algemon Meriweather, July 2, 1851. Set one quarter post from which a 24" hemlock bears S 50°W, 10 links and a 20" hemlock bears N 65°E, 25 links. No evidence found.  
 -Corner recorded LA, pg. 294 by J. Garske, P.S.

B. Description of corner evidence found and/or method applied in restoring or reestablishing corner:

I found a one-half inch iron pipe at the corner location. I accepted this corner as being the one-quarter corner as it is tied into many surveys of record in the area by several surveyors including Earl Applekamp, P.S. and Robert Mick, P.S.  
 This corner was recorded by myself in December of 1993 as noted above, however, the bearing trees were in correctly noted on that Land Corner Certificate and this certificate is being filed to correct that mistake in Liber 4, pg. 294.

PEER GROUP APPROVED


*Richard L. Drizin 6/10/97*  
 COUNTY REPRESENTATIVE

(Record Research on File)

C. Description of monument for corner and accessories established to perpetuate locating the position of the corner:

Replaced found iron pipe with a 3/4"x 30" rebar and 3 1/2" aluminum Bernsten cap stamped: County Remonumentation; T47N, R42W; S-3; S-10; 1/4 Cor; 1993; RLS 28410. Established the following bearing trees and or reference objects:

- 4" Ash - N20°E - 4.61 feet
- 5" Ash - S10°W - 5.87 feet
- Twin 8" Ash - N64°W - 62.22 feet
- Iron pipe-West-100.00 feet
- 6' Steel sign post-East-1.32 feet

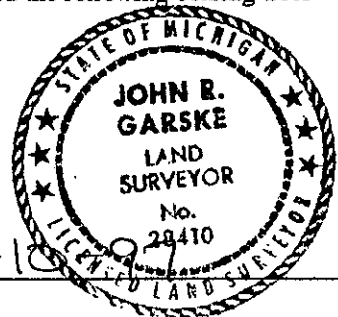

Signed by John R. Garske  
 Surveyor's Michigan License No. 28410

Date 6-10-97