

MAR 02 2000

SECTION

LAND CORNER RECORDATION CERTIFICATE
Filing Requirement of Act 74, Mich. P.A. 1970

Register's office }
Gogebic County } ss.

For corners in

<u>ONTONAGON</u> (County) <u>GOGEBIC</u>	Located In:	Corner Code #
1. Public Land Survey	T 48NR 41W	A - 13
	T 48NR 42W	M - 13
	T 47NR 41W	A - 1
	T 47NR 42W	M - 1
2. Property Controlling in Section	S ___ T ___ R ___	___
	S ___ T ___ R ___	___
3. Miscellaneous Property in Sec.	S ___ T ___ R ___	___
	S ___ T ___ R ___	___

Received for record the
10th day of NOVEMBER
A. D. 1999 at 11:25 o'clock
A. m., and recorded in
Liber 7 of CORNERS
on page 268
Ramona Collins, Deputy
Register of Deeds


Register of Deeds Stamp & File Number

4. Lot No. _____, Recorded Plat _____
5. Private Claims _____

Township Corner 1, 6, 31 & 36, T47 - 48N, R41 - 42W.

I, Earl W. Applekamp, in a field survey on Sept. 23 1999 do hereby state that under requirements of P.A. 74, Michigan P.A. of 1970, the corner points mentioned in lines 1 and 2 above were in conformance with regulations and rules therefore as required in the current manual of survey instructions of the United States Department of the Interior, Bureau of Land Management or by a decree of a Court of Law and/or that the corner points mentioned in lines 3, 4 and 5 above were in conformance with the rules of the Michigan Board of Land Surveyors or by a Decree of a Court of Law; established, re-established, monumented, recovered, found as expressed below:

NOTE: Not more than 2 corners, all in the same town and range, may be recorded on this certificate.

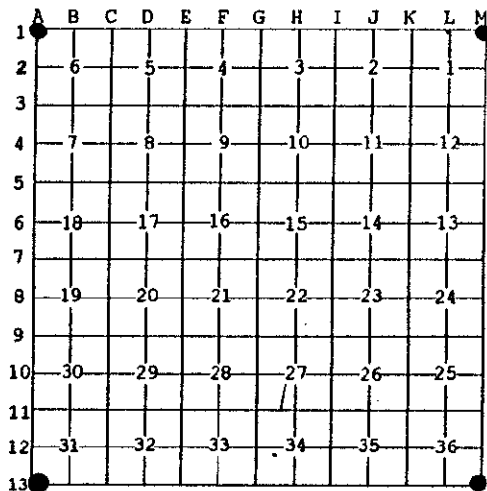

A. Description of original monument and accessories and/or subsequent restoration:

Original corner established by William A. Burt, U.S. Deputy Surveyor in 1847, set Cedar Post.

ORIGINAL BEARING TREES:

24" Hemlock	N15°W	40 Links
14" Hemlock	S20°E	31 Links

DEED GROUP APPROVED
Earl W. Applekamp
COUNTY REGISTER
10-14-99

B. Description of corner evidence found and/or method applied in restoring or reestablishing corner:


Neal Sperhake, RLS recovered the original Hemlock bearing tree at S20°E, 31 Links on 11-1-61. At the corner position he set a 1"X36" long iron pipe monument with a 4" diameter cast aluminum cap, stamped to indicate corner position. He established four new bearing trees: Hemlock 14" N64°W 31 Links, Cedar 14" M18°E 37 Links, Cedar 16" S46°E 31 Links, Hemlock 10" S73°W 40 Links. On October 12, 1978, Richard Drahn, RLS 21564 verified the position of Sperhake's monument from the remains of the original Hemlock bearing trees. He found Sperhake's four bearing trees and filed an Act 74 Certificate which was recorded on April 25, 1979 in Liber 1, Page 131.

C. Description of monument for corner and accessories established to perpetuate locating the position of the corner:

In September 1999 I used the corner and found the monument to be in excellent condition. Three of the bearing trees set by Sperhake are in good condition. The 16" Cedar S46°E 31 Links, has been cut down. The monument set by Sperhake is 1½ feet above ground and has a Steel Sign Post S40°W 1.25 feet. I established one new bearing tree. Nail in a 6" H. Maple N18°E 24.42 feet.

Remonumentation

Research on file with the Ontonagon County _____ Program Representative.

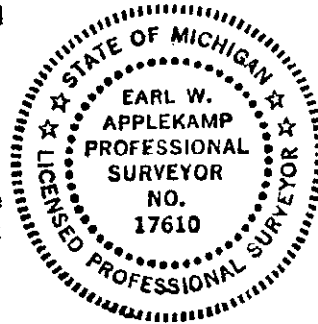

Signed by Earl W. Applekamp
Surveyor's Michigan License No. 17610

Date September 29, 1999