

MAR 02 2000

SECTION

LAND CORNER RECORDATION CERTIFICATE
Filing Requirement of Act 74, Mich. P.A. 1970

Register's Office }
Gogebic County } ss.

For corners in

GOGEBIC

(County)

Located In:

Corner Code #

Sec. 1

Received for record the
22ND day of OCTOBER
A. D. 1999 at 11:20 o'clock
A M., and recorded in
Liber 7 of CORNERS
on page 254.
Ramona Collins, Deputy
Register of Deeds

1. Public Land Survey

T47NR 41W

C-1

T	R	_____	
T	R	_____	
T	R	_____	
T	R	_____	
S	T	R	_____
S	T	R	_____
S	T	R	_____
S	T	R	_____

2. Property Controlling in Section

3. Miscellaneous Property in Sec.

4. Lot No. _____, Recorded Plat _____

5. Private Claims _____

Section Corner common to Sections 31 & 32, T48N, T41W & Sections 5 & 6, T47N R41W.

I, Earl W. Applekamp, in a field survey on Sept. 13, 1999 do hereby state that under requirements of P.A. 74, Michigan P.A. of 1970, the corner points mentioned in lines 1 and 2 above were in conformance with regulations and rules therefore as required in the current manual of survey instructions of the United States Department of the Interior, Bureau of Land Management or by a decree of a Court of Law and /or that the corner points mentioned in lines 3, 4 and 5 above were in conformance with the rules of the Michigan Board of Land Surveyors or by a Decree of a Court of Law; established, re-established, monumented, recovered, found as expressed below:

NOTE: Not more than 2 corners, all in the same town and range, may be recorded on this certificate.

CORRECTION: SEE LIBER 7, PAGE 270

A	B	C	D	E	F	G	H	I	J	K	L	M
1												
2	6		5		4		3		2		1	
3												
4	7		8		9		10		11		12	
5												
6	18		17		16		15		14		13	
7												
8	19		20		21		22		23		24	
9												
10	30		29		28		27		26		25	
11												
12	31		32		33		34		35		36	
13												

Register of Deeds Stamp & File Number

PEER GROUP APPROVED
Richard P. Deahn 10/14/99
COUNTY REPRESENTATIVE

A. Description of original monument and accessories and/or subsequent restoration:
Original Corner established by William A. Burt, U.S. Deputy Surveyor, July 17, 1851. Set Cedar Post in swamp.

ORIGINAL BEARING TREES:

16" Hemlock	N59°E	25.74 feet
24" Tamarack	N67°W	26.40 feet

Going West on South side of Section 32, there was a GLO call of 79 chains, enter swamp. 80.00, chains set corner.

B. Description of corner evidence found and/or method applied in restoring or reestablishing corner:


I ran a traverse from the SE corner of Section 33, two miles to the East using the original field notes in order to get a search area. I found the remains of the Hemlock described above and about 15 feet of a portion of the trunk. Both were in extremely bad condition. Using this to position the corner, it is in agreement with a GLO call Enter swamp 79 chains West of the SE Corner. A yellow tag was in a 12" Aspen N40°E. 100+ feet from the corner position. This is in error, as it would place the corner on high ground. I set the corner using the Hemlock bearing tree and the swamp call.

Research on file with the Ontonagon County Remonumentation Program Representative.

C. Description of monument for corner and accessories established to perpetuate locating the position of the corner:

At the corner position I set a 2 1/2"x30" split base aluminum pipe with a 3" cap stamped to read: County Remonumentation, T48N, T47N R41W, S31, S32 S5, S6, P.S. 1999, 17610. I established 3 bearing trees and a steel sign post.

Nail in 6" Spruce	S71°W	21.03'	-	Nail in 4 1/2" Elm	N28°E	63.10'
Nail in 8" Balsam	S21°E	37.40'	-	6' Steel Sign Post	North	1.1 feet

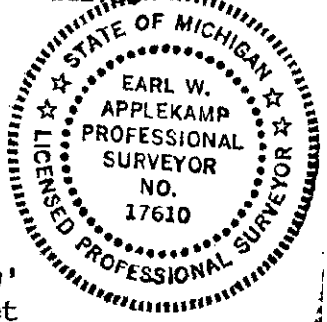

Signed by Earl W. Applekamp

Surveyor's Michigan License No. 17610

Date September 16, 1999