

MAR 02 2000

SECTION

LAND CORNER RECORDATION CERTIFICATE  
Filing Requirement of Act 74, Mich. P.A. 1970

For corners in

GOGEBIC  
(County)

Located In:

Corner Code #

1. Public Land Survey

T 47N R 41W D-1

2. Property Controlling  
in Section

S      T      R     

3. Miscellaneous  
Property in Sec.

S      T      R     

4. Lot No. \_\_\_\_\_, Recorded Plat \_\_\_\_\_

5. Private Claims \_\_\_\_\_

W.C. to  $\frac{1}{4}$  Corner common to Sections 32 & 5 T48, 47N R41W.

I, Earl W. Applekamp, in a field survey on Sept. 15 1999 do hereby state that under requirements of P.A. 74, Michigan P.A. of 1970, the corner points mentioned in lines 1 and 2 above were in conformance with regulations and rules therefore as required in the current manual of survey instructions of the United States Department of the Interior, Bureau of Land Management or by a decree of a Court of Law and /or that the corner points mentioned in lines 3, 4 and 5 above were in conformance with the rules of the Michigan Board of Land Surveyors or by a Decree of a Court of Law; established, re-established, monumented, recovered, found as expressed below:

NOTE: Not more than 2 corners, all in the same town and range, may be recorded on this certificate.

*CORRECTION: SEE LIBER 7, PAGE 271*

A. Description of original monument and accessories and/or subsequent restoration:

Original corner established by William A. Burt, U.S. Deputy Surveyor, June 1851. Set Cedar Post.

ORIGINAL BEARING TREES:

8" Hemlock N39°E 11.88 feet  
6" Cedar N59°W 7.92 feet

DEER GROUP APPROVED

Richard L. Drahm 10/14/99  
COUNTY REGISTER OF DEEDS

B. Description of corner evidence found and/or method applied in restoring or reestablishing corner:

No original evidence was found. Corner position falls in a large beaver pond. I re-established the corner position by single proportionate measure and on line between opposite corners East & West. Because the corner fell in the beaver pond, I established a witness corner on the section line N89°-47'-59"E, 194.32 feet from the true  $\frac{1}{4}$  corner position.

Research on file with the Ontonagon County Remonumentation Program Representative.

C. Description of monument for corner and accessories established to perpetuate locating the position of the corner:

At the witness corner I set a 2 $\frac{1}{2}$ "X30" split base aluminum pipe with a 3" cap stamped to read: County Remonumentation, T48N, T47N, R41W, W.C.,  $\frac{1}{4}$ , S32, S5, S89°-47'-59"W, 194.32, 1999. P.S. 17610. I established three bearing trees and a Steel Sign Post,

Nail in 8" Maple N03°E 74.07' - Nail in 5" Maple S66°E 56.49'  
Nail in 7" Maple N49°E 36.84' - 6' Steel Sign Post South 0.55'


Register's Office }  
Gogebic County } ss.

Received for record the  
22<sup>nd</sup> day of OCTOBER  
A. D. 1999 at 11:20 o'clock  
A m., and recorded in  
Liber 7 of CORNERS  
on page 255

Ramona Collins, Deputy  
Register of Deeds

Register of Deeds Stamp & File Number

1	A	B	C	D	E	F	G	H	I	J	K	L	M
2		6		5		4		3		2		1	
3													
4		7		8		9		10		11		12	
5													
6		18		17		16		15		14		13	
7													
8		19		20		21		22		23		24	
9													
10		30		29		28		27		26		25	
11													
12		31		32		33		34		35		36	
13													

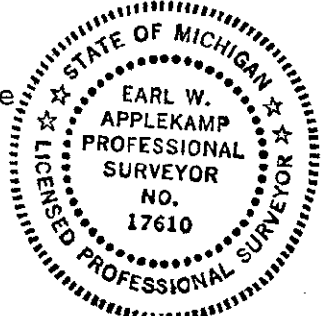

Signed by Earl W. Applekamp  
Surveyor's Michigan License No. 17610

Date September 17, 1999