

SURVEY & REMONUMENTATION

SEP 08 1998

SECTION

LAND CORNER RECORDATION CERTIFICATE
Filing Requirement of Act 74, Mich. P.A. 1970

Register's Office }
Gogebic County } ss.

For corners in

Gogebic

(County)

Located In:

Corner Code #

1. Public Land Survey

T47N R43W	A-8
T47N R44W	M-8
T___ R___	___
T___ R___	___
S___ T___ R___	___
S___ T___ R___	___
S___ T___ R___	___
S___ T___ R___	___

2. Property Controlling in Section

3. Miscellaneous Property in Sec.

Received for record the
23RD day of JULY
A. D. 1998 at 11:40 o'clock
A m., and recorded in
Liber 7 of CORNERS
on page 30
Ramona Collins, Deputy
Register of Deeds

Register of Deeds Stamp & File Number

4. Lot No. _____, Recorded Plat _____
5. Private Claims _____

Quarter corner common to sec's. 24 & 19, T47N, R.43-44

I, John P. Goss, in a field survey on July 22, 1998 do hereby state that under requirements of P.A. 74, Michigan P.A. of 1970, the corner points mentioned in lines 1 and 2 above were in conformance with regulations and rules therefore as required in the current manual of survey instructions of the United States Department of the Interior, Bureau of Land Management or by a decree of a Court of Law and/or that the corner points mentioned in lines 3, 4 and 5 above were in conformance with the rules of the Michigan Board of Land Surveyors or by a Decree of a Court of Law; established, re-established, monumented, recovered, found as expressed below:

NOTE: Not more than 2 corners, all in the same town and range, may be recorded on this certificate.

	A	B	C	D	E	F	G	H	I	J	K	L	M
1													
2		6		5		4		3		2		1	
3													
4		7		8		9		10		11		12	
5													
6		18		17		16		15		14		13	
7													
8		19		20		21		22		23		24	
9													
10		30		29		28		27		26		25	
11													
12		31		32		33		34		35		36	
13													

A. Description of original monument and accessories and/or subsequent restoration:

Corner established by Austin Burt, U.S. Deputy Surveyor, in 1847.

Original bearing trees: Yellow Birch 18" S 55° W 2 links
Yellow Birch 16" N 60° E 23 links

On June 16, 1971, Donald D. Lappala, RLS, USFS, restored corner position at record bearing and distance from the second Y. Birch B.T. and natural features ties. He set a 2 1/2" I.D. galv. iron pipe with 3" circular bronze tablet which reads: T.47 N., R.43-44 W.: S-19, S-24; 1/4; R.L.S. 12585; 1971, from which he established the following reference objects: 6" Cedar - N 68° W - 19.5'; 7" Cedar - N 07° W - 17.7'; 5" Cedar - S 59° E - 17.9'

B. Description of corner evidence found and/or method applied in restoring or reestablishing corner:

4"x4" Cedar sign post (Out) - N 60° W - 2.7'.

He recorded said corner in U.S. Forest Service Liber P-25 on August 10, 1972.

Found D. Lappala monument and witnesses.

I updated the monument and accessories as noted below to state and county specification.

Act 74 research on file.

PEER GROUP APPROVAL


Richard L. Deah 7/22/98
COUNTY REPRESENTATIVE

C. Description of monument for corner and accessories established to perpetuate locating the position of the corner:

From the found monument I established the following existing and new reference objects:

7" Cedar	N 68° W	19.58'
9" Cedar	N 07° W	17.70'
6" Cedar	S 59° E	17.95'
6' rail & sign	S 52° W	2.30' to face

(All measurement taken to nail in side of tree)

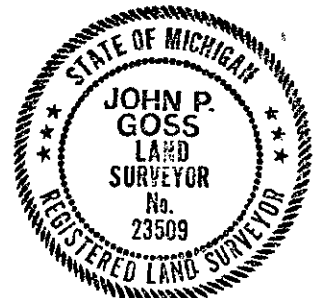

Signed by John P. Goss

Date July 22, 1998

Surveyor's Michigan License No. 23509

U.S.F.S. No. P-25