

DEC 15 1998

LAND CORNER RECORDATION CERTIFICATE  
Filing Requirement of Act 74, Mich. P.A. 1970

Register's Office }  
Gogebic County } ss.

SECTION

For corners in

Gogebic

(County)

Located In:

Corner Code #

1. Public Land Survey

T.46N R.43W A- 1  
T.46N R.44W M- 1  
T.47N R.43W A- 13  
T.47N R.44W M- 13

2. Property Controlling in Section

S \_\_\_ T \_\_\_ R \_\_\_  
S \_\_\_ T \_\_\_ R \_\_\_

3. Miscellaneous Property in Sec.

S \_\_\_ T \_\_\_ R \_\_\_  
S \_\_\_ T \_\_\_ R \_\_\_

Received for record the  
17<sup>th</sup> day of SEPTEMBER  
A. D. 1998 at 1:15 o'clock  
9 m., and recorded in  
Liber 7 of CORNERS

on page 54  
Ramona Collins Deputy  
Register of Deeds

Register of Deeds Stamp & File Number

4. Lot No. \_\_\_\_\_, Recorded Plat \_\_\_\_\_  
5. Private Claims \_\_\_\_\_

Section corner common to sec's. 1, 6, 31 & 36  
T.46N, R.43-44W; T.47N, R.43-44W &

I, John P. Goss, in a field survey on Sept. 1 19 98 do hereby state that under requirements of P.A. 74, Michigan P.A. of 1970, the corner points mentioned in lines 1 and 2 above were in conformance with regulations and rules therefore as required in the current manual of survey instructions of the United States Department of the Interior, Bureau of Land Management or by a decree of a Court of Law and/or that the corner points mentioned in lines 3, 4 and 5 above were in conformance with the rules of the Michigan Board of Land Surveyors or by a Decree of a Court of Law; established, re-established, monumented, recovered, found as expressed below:

NOTE: Not more than 2 corners, all in the same town and range, may be recorded on this certificate.

1	A	B	C	D	E	F	G	H	I	J	K	L	M
2		6		5		4		3		2		1	
3													
4		7		8		9		10		11		12	
5													
6		10		17		16		15		14		13	
7													
8		19		20		21		22		23		24	
9													
10		30		29		28		27		26		25	
11													
12		31		32		33		34		35		36	
13													

A. Description of original monument and accessories and/or subsequent restoration:

Corner established by Austin Burt, U.S. Deputy Surveyor, in 1847.  
Original bearing trees: Black Ash 10" S 48° W 18 links  
Henlock 12" S 77° E 12 links

On June 4, 1971, Donald D. Lappala, R.L.S., USFS, restored corner position at record bearing and distance from remains of two original bearing trees. He set a 2½" I.D. iron pipe, capped with a 3" Bronze tablet which reads: T.46-47 N, R.43-44 W; S-, S-6, S31, S-36; R.L.S. 12585; 1971, from which he established the following reference objects: 7" Red Maple - N 37° E- 13.1'; 6" Spruce - S 60° E - 33.4'; 6" Red Maple - S 11° E - 28.1'; 4"x4" Cedar sign post - S 58° E 2.4'

B. Description of corner evidence found and/or method applied in restoring or reestablishing corner: 2.4'  
He record said corner in U.S. Forest Service Liber Z-25 on August 10, 1972.  
Found D. Lappala monument and reference objects.

I updated the monument and accessories as noted below to state and county specification.

Act 74 research on file.

PEER GROUP APPROVED

Richard P. Deahn 9/16/98  
COUNTY REGISTER

C. Description of monument for corner and accessories established to perpetuate locating the position of the corner:

From found monument I established the following existing and new reference objects:

9" Red Maple N 37° E 13.11'  
9" Spruce S 60° E 33.61'  
11" Red Maple S 11° E 28.07'  
4"x4" Cedar sign post S 58° E 2.34' to face  
6' Rail & Sign N 10° W 1.92' to face


(All measurement taken to nail in side of tree)



Signed by John P. Goss  
Surveyor's Michigan License No. 23509

Date Sept. 1, 1998

U.S.F.S. No. Z-25

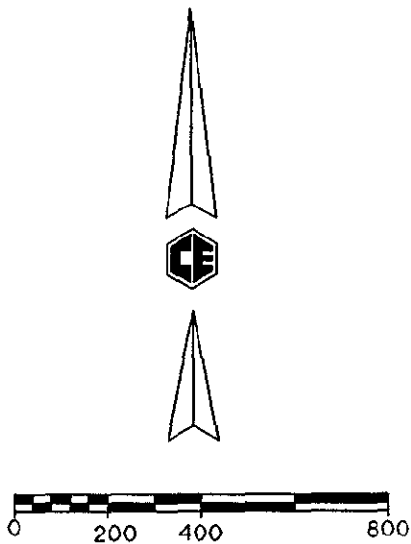

SURVEY &  
REMONUMENTATION

DEC 15 1998

SECTION

UNDERWOOD GRADE 25 30 MONUMENTED RECORDED CORNER 36 31

R 47 W R 46 W

RANGE LINE

N 00° 33' 06" E  
2630.04' (M)  
2640.00' (R-GLO)

1/4 COR.  
36 31  
ESTABLISHED BY SINGLE PROPORTION

N 00° 33' 06" E  
1578.02' (M)  
1584.00' (R-GLO)

CLOSING CORNER ESTABLISHED ON STATE LINE BY SINGLE PROPORTION

MONTREAL RIVER  
MILE MARKER NO. 0  
FOUND. CONC. MON'T. (REC.)  
APPROX. LOCATION

MICHIGAN

WISCONSIN

S 74° 29' 49" E 1522.62' (R-BURT)(23.07 CH.)  
1523.16' (M)

S 74° 29' 49" E 2652.84' (M)  
S 74° 27' E (R) 2640' (R-BURT-1847)  
2651.9' (HARRINGTON-1928)

MICHIGAN

WISCONSIN

S 74° 29' 49" E 1129.68' (M)  
STATE LINE

MILE MARKER NO. 1/2  
FOUND. CONC. MON'T. (REC.)