

LAND CORNER MONUMENTS

JAN 20 1999


T. 47 N., R. 43 W.

SECTION

MARANISCO TOWNSHIP

ONTONAGON COUNTY

State Index

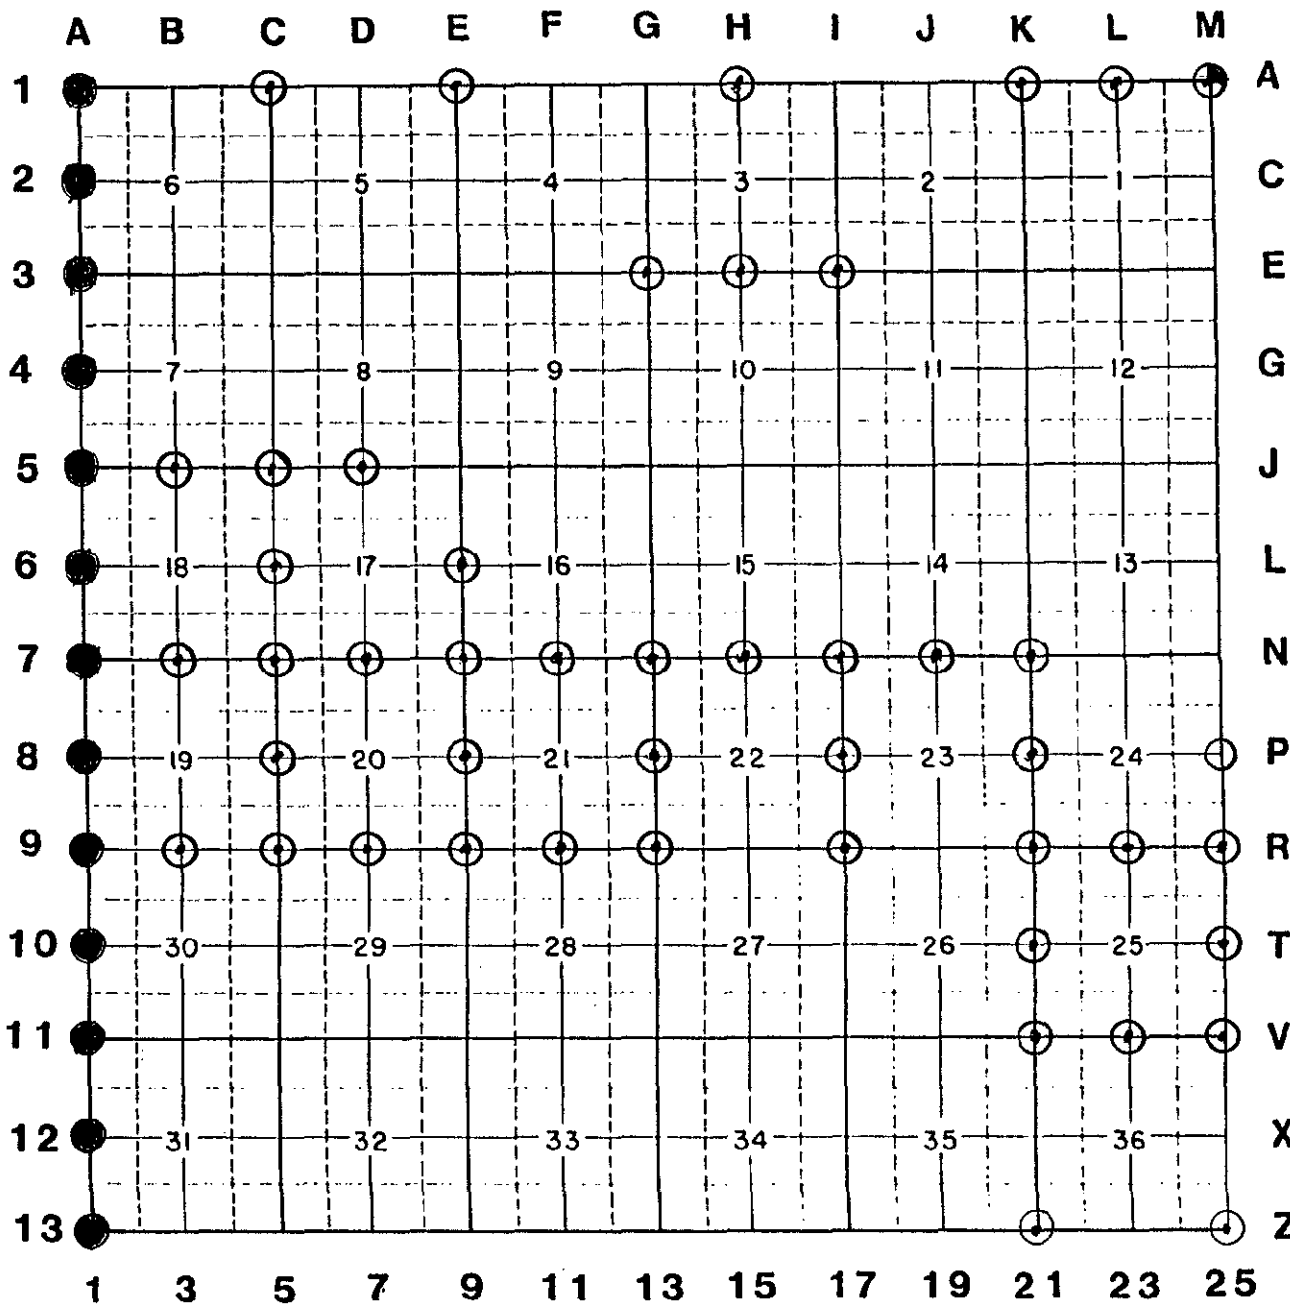

Federal Index

AS OF 12/31/98

LEGEND

- GLO Corners researched
- ⊙ GLO Corners monumented, not approved
- ⊗ GLO Corners approved
- GLO Corners approved & reported to State

T. 47 N., R. 43 W.