

**SURVEY &
REMONUMENTATION**

AUG 08 1997

COMMISSION

LAND CORNER RECORDATION CERTIFICATE
Filing Requirement of Act 74, Mich. P.A. 1970

Register's Office }
Gogebic County } ss.

For corners in

Gogebic
(County)

Located In:

Corner Code #

1. Public Land Survey

T.47 N. R. 44 W. A-2
T.47 N. R. 45 W. M-2

2. Property Controlling
in Section

S T R
S T R

3. Miscellaneous
Property in Sec.

S T R
S T R

4. Lot No. _____, Recorded Plat _____

5. Private Claims _____

1/4 cor. comm. to sec's. 1 & 6

I, John P. Goss, in a field survey on June 2, 1997 do hereby state that under requirements of P.A. 74, Michigan P.A. of 1970, the corner points mentioned in lines 1 and 2 above were in conformance with regulations and rules therefore as required in the current manual of survey instructions of the United States Department of the Interior, Bureau of Land Management or by a decree of a Court of Law and/or that the corner points mentioned in lines 3, 4 and 5 above were in conformance with the rules of the Michigan Board of Land Surveyors or by a Decree of a Court of Law; established, re-established, monumented, recovered, found as expressed below:

NOTE: Not more than 2 corners, all in the same town and range, may be recorded on this certificate.

A. Description of original monument and accessories and/or subsequent restoration:

Original corner established by Austin Burt on Sept. 1, 1847. Set Hemlock post.
Original bearing trees: Hemlock 14" S 73° W 21 links
Sugar 7" N 49° E 23 links

On August 21, 1986, Richard Drahn, RLS, reestablish the corner position on line and proportionate distances from Section corners: 39 chain North and 80 chain South. He set a 2" I.D. iron pipe with 3" brass cap, stamped to indicate corner position. He record said corner in Liber 3 page 24 of Land Corners for Gogebic County. He established the following reference objects. 7" S. Maple - N 06° E 40.38'; 8" Cedar - N 88° E - 11.83'; 7" S. Maple - S 11° E - 46.17'; 6' Metal

B. Description of corner evidence found and/or method applied in restoring or reestablishing corner:

Sign Post - N 89° E - 1.8'

No original evidence could be found.

Found Drahn, 2" iron pipe with brass cap. It checked with Drahn witnesses. I updated the accessories as noted below to state and county specification.

Act 74 research on file.

PEER GROUP APPROVED

Richard Drahn 6/10/97
COUNTY SURVEYOR


C. Description of monument for corner and accessories established to perpetuate locating the position of the corner:

From the 2" I.D. iron pipe with 3" brass cap marked T.47 N., R.44-45 W.; 1/4; S-1, S-6; 1986; R.L.S. 21564. I established the existing and new bearing trees and reference objects.

9" Sugar Maple N 06° E 40.38'
8" Cedar (Stub) N 88° E 11.83'
10" Sugar Maple S 11° W 46.17'
8" Basswood N 45° W 16.91'
6' Metal sign post N 89° E 1.8' (to face of post)
6' Rail & Sign S 60° W 2.0' (to face of rail)
(measurement to nail in side of tree)

Signed by John P. Goss
Surveyor's Michigan License No. 23509

Date June 3, 1997

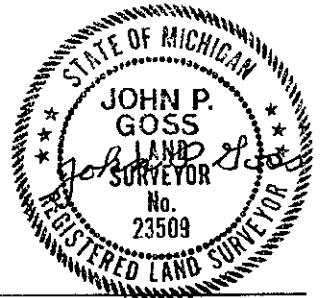

Register of Deeds Stamp & File Number

Received for record the
11th day of JUNE
A. D. 1997 at 10:35 o'clock
A m., and recorded in
Liber 6 of CORNERS
on page 143
Colleen M. K. Cook Deputy
Register of Deeds

	A	B	C	D	E	F	G	H	I	J	K	L	M
1													
2	6		5		4		3		2		1		
3													
4	7		8		9		10		11		12		
5													
6	18		17		16		15		14		13		
7													
8	19		20		21		22		23		24		
9													
10	30		29		28		27		26		25		
11													
12	31		32		33		34		35		36		
13													