

**SURVEY & REMONUMENTATION**

AUG 08 1997

COMMISSION

**LAND CORNER RECORDATION CERTIFICATE**  
Filing Requirement of Act 74, Mich. P.A. 1970

Register's Office }  
Gogebic County } ss.

For corners in

Gogebic  
(County)

Located In:

Corner Code #

1. Public Land Survey

<u>T47NR 44W</u>	<u>A-3</u>
<u>T47NR 45W</u>	<u>M-3</u>
T R	
T R	
S T R	
S T R	
S T R	
S T R	

2. Property Controlling in Section

3. Miscellaneous Property in Sec.

4. Lot No. \_\_\_\_\_, Recorded Plat \_\_\_\_\_

5. Private Claims \_\_\_\_\_

Sec. cor. comm. to sec's. 1,6,7 & 12

I, John P. Goss, in a field survey on June 2, 1997 do hereby state that under requirements of P.A. 74, Michigan P.A. of 1970, the corner points mentioned in lines 1 and 2 above were in conformance with regulations and rules therefore as required in the current manual of survey instructions of the United States Department of the Interior, Bureau of Land Management or by a decree of a Court of Law and/or that the corner points mentioned in lines 3, 4 and 5 above were in conformance with the rules of the Michigan Board of Land Surveyors or by a Decree of a Court of Law; established, re-established, monumented, recovered, found as expressed below:

NOTE: Not more than 2 corners, all in the same town and range, may be recorded on this certificate.

Received for record the  
11<sup>th</sup> day of JUNE

A. D. 1997 at 10:35 o'clock

A m., and recorded in

Liber 6 of CORNERS

on page 144

Colleen M. Kichak, Deputy  
Register of Deeds

Register of Deeds Stamp & File Number

	A	B	C	D	E	F	G	H	I	J	K	L	M
1													
2	6		5		4		3		2		1		
3													
4	7		8		9		10		11		12		
5													
6	18		17		16		15		14		13		
7													
8	19		20		21		22		23		24		
9													
10	30		29		28		27		26		25		
11													
12	31		32		33		34		35		36		
13													

A. Description of original monument and accessories and/or subsequent restoration:

Original corner established by Austin Burt on Sept, 1, 1847. Set Sugar post.  
Original bearing trees: Y. Birch 16" S 09° E 17 links  
Spruce 16" N 67° W 47 links  
Fir 14" N 65° E 15 links

On August 21, 1986, Richard Drahn, RLS, reestablished the corner position on line and equal distance between W $\frac{1}{4}$  corners of sections 1 and 12. He set a 2" I.D. iron pipe with 3" brass cap, stamped to indicated corner position. He record said corner in Liber 3, page 25 of Land Corners for Gogebic County. He established the following reference objects: 11" White Ash - N 69° E - 37.47';

B. Description of corner evidence found and/or method applied in restoring or reestablishing corner:

Y. Birch - S 54° E - 25.46'; 6" Black Ash - N 41° W - 33.97'; 6' metal sign post - S 59° E - 2.0'.

No original evidence could be found.

Found Drahn 2" iron pipe with brass cap. It checked with Drahn witnesses. I updated the accessories as noted below to state and county specification.

Act 74 research on file.


**DEED GROUP APPROVAL**  
Richard P. Drahn 6/10/97  
**COUNTY REPRESENTATIVE**

C. Description of monument for corner and accessories established to perpetuate locating the position of the corner:

From the 2" I.D. iron pipe with 3" brass cap mark, T.47 N., R.44-45 W.; S-6, S-7, S-1, S-12; 1986; R.L.S. 21564. I established the existing and new bearing trees and reference objects.

12" White Ash (stub)	N 69° E	37.47'	
18" Yellow Birch	S 54° E	25.16'	
9" Black Ash	N 41° W	33.92'	
13" Basswood	S 58° W	14.09'	
6' Metal sign post	S 59° E	2.0'	(to face of post)
6' Rail & Sign	N 61° W	2.0'	(to face of rail)

(measurement to nail in side of tree)

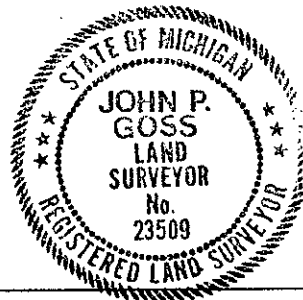

Signed by John P. Goss

Date June 3, 1997

Surveyor's Michigan License No. 23509

Fed No. E-25