

SURVEY & REMONUMENTATION

AUG 08 1997

COMMISSION

LAND CORNER RECORDATION CERTIFICATE
Filing Requirement of Act 74, Mich. P.A. 1970

Register's Office }
Gogebic County } ss.

For corners in

Gogebic
(County)

Located In: Corner Code #

1. Public Land Survey

T47NR 44W A-12
T47NR 42W M-12

2. Property Controlling in Section

T ___ R ___
T ___ R ___

3. Miscellaneous Property in Sec.

S ___ T ___ R ___
S ___ T ___ R ___
S ___ T ___ R ___

4. Lot No. _____, Recorded Plat _____

5. Private Claims _____

1/4 cor. comm. to sec's. 31 & 36

I, John P. Goss, in a field survey on May 6, 1997 do hereby state that under requirements of P.A. 74, Michigan P.A. of 1970, the corner points mentioned in lines 1 and 2 above were in conformance with regulations and rules therefore as required in the current manual of survey instructions of the United States Department of the Interior, Bureau of Land Management or by a decree of a Court of Law and/or that the corner points mentioned in lines 3, 4 and 5 above were in conformance with the rules of the Michigan Board of Land Surveyors or by a Decree of a Court of Law; established, re-established, monumented, recovered, found as expressed below:

NOTE: Not more than 2 corners, all in the same town and range, may be recorded on this certificate.

Received for record the
13TH day of MAY

A. D. 1997 at 2:10 o'clock
P m., and recorded in

Liber 6 of CORNERS

on page 124

Ramona Collins Deputy
Register of Deeds

Register of Deeds Stamp & File Number

A	B	C	D	E	F	G	H	I	J	K	L	M
1												
2	6	5	4	3	2	1						
3												
4	7	8	9	10	11	12						
5												
6	18	17	16	15	14	13						
7												
8	19	20	21	22	23	24						
9												
10	30	29	28	27	26	25						
11												
12	31	32	33	34	35	36						
13												

A. Description of original monument and accessories and/or subsequent restoration:

Original corner established by Austin Burt in 1847. Set sugar post.

Original bearing trees: Sugar Maple 18" S 76° E 12 links
Hemlock 12" N 69° W 14 links

On Sept. 29, 1970, Donald Lappala, RLS., recovered two (2) original bearing trees and restored corner position at record bearing and distance from original bearing trees. At the corner position he set a 2 1/2" iron pipe with 3" bronze table which read: T. 47 N., R. 44-45 W.; 1/4; S-31, S-36; R.L.S. 12585; 1970. He recorded said corner in Forest Service Liber for land corners in Register of Deeds Office for Gogebic County, from which he established the following

B. Description of corner evidence found and/or method applied in restoring or reestablishing corner:

new blazed and scribed bearing trees: 7" Sugar Maple - N 62° W - 27.1';
7" Sugar Maple - N 13° E - 12.9'; 11" Sugar Maple - S 16° E - 22.2'
In 1985 a 6' Steel Rail - West - 1.25' was added.

Found the monument and bearing trees as described above.

Act 74 research on file.


C. Description of monument for corner and accessories established to perpetuate locating the position of the corner:

From the Monument, I established existing and new bearing trees and reference objects.

11" Sugar Maple	N 62° W	27.12'
9" Sugar Maple	N 13° E	12.88'
13" Sugar Maple	S 16° E	22.21'
6' Steel Sign	West	1.25'
13" Basswood	S 88° W	22.98'

PEER GROUP APPROVED

Richard P. Dralun 5/12/97
COUNTY REPRESENTATIVE

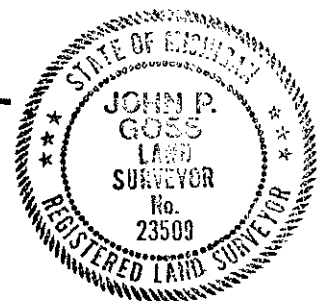

(All measurement to trees taken to nail in side)

Signed by John P Goss
Surveyor's Michigan License No. 23509

Date May 6, 1997

Fed. No. X-25