

**SURVEY &
REMONUMENTATION**

OCT 03 1996

COMMISSION

**LAND CORNER RECORDATION CERTIFICATE
Filing Requirement of Act 74, Mich. P.A. 1970**

Register's Office }
Gogebic County } ss.

Received for record the
10TH day of JUNE
A. D. 1996 at 10:00 o'clock
A m., and recorded in
Liber 5 of CORNER
on page 366
Ramona Collins, Deputy
Register of Deeds

Register of Deeds Stamp & File Number

For corners in

Gogebic
(County)

Located In:

Corner Code ##

- | | | |
|---------------------------------------|--------------------------------|------------|
| 1. Public Land Survey | T <u>47</u> N. R. <u>44</u> W. | <u>C-7</u> |
| | T _____ R _____ | _____ |
| | T _____ R _____ | _____ |
| | T _____ R _____ | _____ |
| 2. Property Controlling in Section | S _____ T _____ R _____ | _____ |
| | S _____ T _____ R _____ | _____ |
| 3. Miscellaneous Property in Sec. | S _____ T _____ R _____ | _____ |
| | S _____ T _____ R _____ | _____ |
| 4. Lot No. _____, Recorded Plat _____ | | |
| 5. Private Claims _____ | | |

Sec. Cor. 17, 18, 19 & 20; T.47 N., R.44 W.

I, Richard L. Drahn in a field survey on May 13, 19 96, do hereby certify that under requirements of P.A. 74, Michigan P.A. of 1970, the corner points mentioned in lines 1 and 2 above were in conformance with regulations and rules therefore as required in the current manual of survey instructions of the United States Department of the Interior, Bureau of Land Management or by a decree of a Court of Law and/or that the corner points mentioned in lines 3, 4 and 5 above were in conformance with the rules of the Michigan Board of Land Surveyors or by a Decree of a Court of Law; established, re-established, monumented, re-monumented, recovered, found as expressed below:

NOTE: Not more than 4 corners, all in the same town and range, may be recorded on this certificate.

A. Description of original monument and accessories and/or subsequent restoration:


Corner established by William Burt in 1848. Original B.T.s --- Hemlock 10" S.45 E. 40 links (26.40') --- Cedar 14" N.45 W. 37 links (24.42').

Corner restored by Donald D. Lappala, RLS 12585, on 10/15/70; from the remains of the two original B.T.s, one still scribed. He set a 2½" by 5' iron pipe with a 3" stamped brass cap and the following new bearing trees: --- Cedar 5" (6') N.64 W. (N.61 W.) 50.2' (50.02') --- Cedar 5" (dead) 15.6' --- Red Maple 6" (10") S.38 W. (S. 40 W.) 17.1' (17.25') ---
Corner recorded in Gogebic County in USFS Liber, Page N-5, on 8/10/72.

B. Description of corner evidence found and/or method applied in restoring or reestablishing corner:

Act 74 research form on file with Gogebic County records.

Recovered the monument as described and the bearing trees as noted in parentheses above. No evidence remains of the original bearing trees.

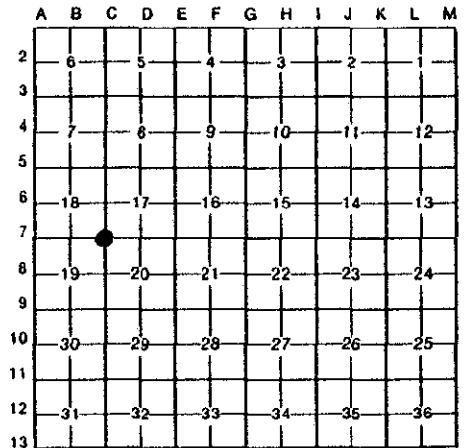

C. Description of monument for corner and accessories established to perpetuate locating the position of the corner:

Bearing objects referenced:

- | | | |
|----------------------------|---------|--------|
| 4" x 4" 7' Cedar sign post | S.67 E. | 2.9' |
| 6' Steel sign rail | N.32 W. | 2.05' |
| 8" Red Maple | N.82 W. | 28.89' |

PEER GROUP APPROVED
Richard L. Drahn 6/6/96
COUNTY REPRESENTATIVE



Signed by Richard L. Drahn

Date May 20, 1996

Surveyor's Michigan License No. 21564