

**SURVEY &
REMONUMENTATION**

OCT 03 1996

COMMISSION

LAND CORNER RECORDATION CERTIFICATE
Filing Requirement of Act 74, Mich. P.A. 1970

Register's Office }
Gogebic County } ss.

Received for record the
8TH day of MAY
A. D. 1996 at 11:00 o'clock
A m., and recorded in
Liber 5 of CORNERS
on page 347
Karona Collins, Deputy
Register of Deeds

Register of Deeds Stamp & File Number

For corners in

<u>Gogebic</u> (County)	Located In:	Corner Code #
1. Public Land Survey	T <u>47N</u> R <u>44</u> W	<u>C-10</u>
	T _____ R _____	_____
	T _____ R _____	_____
	T _____ R _____	_____
2. Property Controlling in Section	S _____ T _____ R _____	_____
	S _____ T _____ R _____	_____
3. Miscellaneous Property in Sec.	S _____ T _____ R _____	_____
	S _____ T _____ R _____	_____

4. Lot No. _____, Recorded Plat _____
5. Private Claims _____

$\frac{1}{4}$ Corner 29 & 30; T.47 N., R.44 W.

I, Richard L. Drahn in a field survey on May 6, 19 96
do hereby certify that under requirements of P.A. 74, Michigan P.A. of 1970, the corner points mentioned
in lines 1 and 2 above were in conformance with regulations and rules therefore as required in the
current manual of survey instructions of the United States Department of the Interior, Bureau of Land
Management or by a decree of a Court of Law and/or that the corner points mentioned in lines 3, 4 and 5
above were in conformance with the rules of the Michigan Board of Land Surveyors or by a Decree of a
Court of Law; established, re-established, monumented, re-monumented, recovered, found as
expressed below:

**NOTE: Not more than 4 corners, all in the same town and range, may be recorded
on this certificate.**

	A	B	C	D	E	F	G	H	I	J	K	L	M
2	6		5		4		3		2		1		
3													
4	7		8		9		10		11		12		
5													
6	18		17		16		15		14		13		
7													
8	19		20		21		22		23		24		
9													
10	30		29		28		27		26		25		
11													
12	31		32		33		34		35		36		
13													

A. Description of original monument and accessories and/or subsequent restoration:
Corner established by William Burt in 1848. Original B.T.s --- Y. Birch 6"
S.70 W., 32 links (21.12') --- Fir 8" N.50 E., 15 links (9.90').
Corner restored by Donald D. Lappala, RLS 12585 from the stump remains of the
two original bearing trees and from natural feature ties north. He set a 2"
by 5' iron pipe with a 3" stamped brass cap and the following new bearing
objects: --- X chiseld on top of 36" x 18" x 12" boulder S.02 E. (S.02 E.)
14.5' (14.5') --- 8" (9") Elm (dead) S.37 W. (S.38 W.) 30.3' --- 10" (14")
Elm (dead) S.85 W. (S.85 W.) 36.1' (36.1').

Corner recorded in Gogebic County in USFS Liber, Page T-5 on 5/27/70.

B. Description of corner evidence found and/or method applied in restoring or reestablishing corner:
Act 74 research form on file with Gogebic County records.

Recovered the monument as described and the bearing objects as noted in
parentheses above. No evidence remains of the original bearing trees.


U.S. Forest Service maintained this corner on 12/9/85 and established the
following new bearing tree.

Sugar Maple 8" S.60 W. 12.37' (12.34')

C. Description of monument for corner and accessories established to perpetuate locating the position of the corner:
Bearing objects referenced:

- 8" Sugar Maple S.54 E. 29.69'
- 6' Steel rail S.18 W. 2.8'
- 4" x 4" x 7' Cedar sign post bears N.22 W. 2.9'

PEER GROUP APPROVED
Richard L. Drahn 5/7/96
COUNTY REPRESENTATIVE

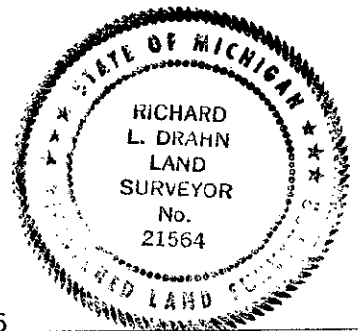

Signed by Richard L. Drahn Date May 7, 1996

Surveyor's Michigan License No. 21564