

NOV 12 1997

COMMISSIONER

LAND CORNER RECORDATION CERTIFICATE
Filing Requirement of Act 74, Mich. P.A. 1970

Register's office }
Gogebic County } ss.

Received for record the
18TH day of SEPTEMBER
A. D. 1997 at 10:45 o'clock
A m., and recorded in
Liber 6 of CORNERS

on page 205
Ramona Collins, Deputy
Register of Deeds

Register of Deeds Stamp & File Number

For corners in

Gogebic
(County)

Located in:

Corner Code #

- 1. Public Land Survey T 47N R 44W E-6
- T _____ R _____
- T _____ R _____
- T _____ R _____
- 2. Property Controlling S _____ T _____ R _____
- in Section S _____ T _____ R _____
- 3. Miscellaneous S _____ T _____ R _____
- Property in Sec. S _____ T _____ R _____

- 4. Lot No. _____, Recorded Plat _____
- 5. Private Claims _____

$\frac{1}{4}$ Corner 16 & 17; T.47 N., R.44 W.

Richard L. Drahn, in a field survey on September 12, 19 97, do hereby certify that under requirements of P.A. 74, Michigan P.A. of 1970, the corner points mentioned in lines 1 and 2 above were in conformance with regulations and rules therefore as required in the current manual of survey instructions of the United States Department of the Interior, Bureau of Land Management or by a decree of a Court of Law and/or that the corner points mentioned in lines 3, 4 and 5 above were in conformance with the rules of the Michigan Board of Land Surveyors or by a Decree of a Court of Law; established, re-established, monumented, re-monumented, recovered, found as expressed below:

NOTE: Not more than 4 corners, all in the same town and range, may be recorded on this certificate.

	A	B	C	D	E	F	G	H	I	J	K	L	M
2	6	5	4	3	2	1							
3	7	8	9	10	11	12							
4													
5													
6	18	17	16	15	14	13							
7													
8	19	20	21	22	23	24							
9													
10	30	29	28	27	26	25							
11													
12	31	32	33	34	35	36							
13													

A. Description of original monument and accessories and/or subsequent restoration:

Corner established by William Burt in 1848. Original B.T.s --- Y. Birch 12" N.47 W. 21 links (13.86') --- Elm 15" S.60 E. 36 links (23.76') ---

Corner restored on 7/25/83 by Richard L. Drahn (21564) from the remains of the original Y. Birch B.T. and the stump hole of the Elm B.T. The distance to natural features and recovered corners north and south were also used to position the corner. He set a 2" X 30" aluminum monument with a 3 1/2" stamped aluminum cap and the following B.T.s: --- 12" (14") Black Ash N.33 W. (N.32 W.) 21.23' (21.25') --- 5" (7") Black Ash N.32 E. (N.30 E.) 22.02' (21.95') ---

B. Description of corner evidence found and/or method applied in restoring or reestablishing corner:

6" (8") Black Ash S.07 E. (S.04 E.) 9.01' (8.94') --- 6' Steel sign rail North 1.3' (1.29') ---

Corner recorded in Liber 2, Page 575 on 2/15/84.

Recovered the corner as described and the bearing trees as indicated in parentheses above.. A large, badly decayed stump is all that remains of the Yellow Birch B.T. No evidence remains of the original Elm B.T.


Research form on file with Gogebic County records.

C. Description of monument for corner and accessories established to perpetuate locating the position of the corner:

From the above described monument I established the following new B.T.:

6" Black Ash S.88 W. 21.67'

PEER GROUP APPROVED
Richard L. Drahn 9/17/97
COUNTY REPRESENTATIVE

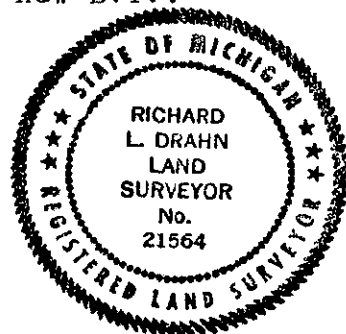

Signed by Richard L. Drahn

Date September 15, 1997

Surveyor's Michigan License No. 21564