

NOV 12 1997

COMMISSION

LAND CORNER RECORDATION CERTIFICATE
Filing Requirement of Act 74, Mich. P.A. 1970

Register's Office } ss.
Gogebic County }

Received for record the
18th day of SEPTEMBER
A. D. 1997 at 10:50 o'clock
A m., and recorded in
Liber 6 of CORNERS

page 215
Ramona Collins, Deputy
Register of Deeds

Register of Deeds Stamp & File Number

For corners in
Gogebic Located In: Corner Code #
1. Public Land Survey T47NR 44W G-9
2. Property Controlling in Section S T R
3. Miscellaneous Property in Sec. S T R

4. Lot No. , Recorded Plat
5. Private Claims

I, John P. Goss, in a field survey on Sept. 12, 1997 do hereby state that under requirements of P.A. 74, Michigan P.A. of 1970, the corner points mentioned in lines 1 and 2 above were in conformance with regulations and rules therefore as required in the current manual of survey instructions of the United States Department of the Interior, Bureau of Land Management or by a decree of a Court of Law and/or that the corner points mentioned in lines 3, 4 and 5 above were in conformance with the rules of the Michigan Board of Land Surveyors or by a Decree of a Court of Law; established, re-established, monumented, recovered, found as expressed below:

NOTE: Not more than 2 corners, all in the same town and range, may be recorded on this certificate.

Section corner comm. to sec's 21, 22, 27 & 28

Grid table with columns A-L and rows 1-13. A dot is marked at the intersection of column G and row 9.


A. Description of original monument and accessories and/or subsequent restoration:
Original corner established by William Burt in 1848.
Original bearing trees: Spruce 16" S 76° E 53 links
Hemlock 22" N 65° W 31 links
On October 22, 1970, Donald D. Lappala, RLS, restored corner position at record bearing and distance from remains of the two original bearing trees. Found roots of trees. Corner position verified further by measurement to recoverable natural features. He set a 2 1/2" iron pipe with 3" bronze cap stamped th indicated corner position; He established the following bearing trees: 6" W. Spruce- N 38° E - 38.0'; 4" W. Spruce (now windfall)- S 78° E - 14.5'; 8" Cedar -

B. Description of corner evidence found and/or method applied in restoring or reestablishing corner.
S 68° W - 69.9'.
Corner recorded in USFS Liber R-13, on August 10, 1970.
Found Donald D. Lappala corner monument and witnesses.

I updated the corner monument and accessories as noted below to state and county specification.
Act 74 research on file.

C. Description of monument for corner and accessories established to perpetuate locating the position of the corner.
From the 2 1/2" iron pipe with 3" bronze cap which reads: T.47 N., R.44 W.; S-21, S-22, S-27, S-28; R.L.S. 12585; 1970, from which I established existing and new bearing trees and reference objects.
7" White Spruce N. 38° E. 37.80'
9" Cedar S. 68° W. 69.93'
6" White Spruce S. 04° E. 37.75'
4"x4" wood post and sign N. 20° E. 3.35' (to face)
6' Rail & Sign N. 53° W. 3.15' (to face)
(All measurement to nail in side of tree)

PEER GROUP APPROVED
Richard P. Goss 9/17/97
COUNTY REPRESENTATIVE

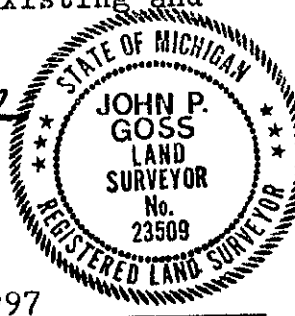

Signed by John P. Goss
Surveyor's Michigan License No. 23509
Fed. No. R-13

Date September 12, 1997