SURVEY &
REMONUMENTATION

SEP 0 8 1998

SECTION

LAND CORNER RECORDATION CERTIFICATE
Filing Requirement of Act 74, Mich. P.A. 1970

Register's Office
Gogebic County } ss.

Received for record the 23RD day of JULY A. D. 1998 at 11:35 o'clock A m., and recorded in Liber 7 of CORNERS on page 20

Ramona Collins, Deputy
Register of Deeds

Register of Deeds Stamp & File Number

For corners in

Gogebic
(County)

	Located In:	Corner Code #
1. Public Land Survey	T47N R 44 W	H-9
	T___ R___	
	T___ R___	
	T___ R___	
2. Property Controlling in Section	S___ T___ R___	
	S___ T___ R___	
3. Miscellaneous Property in Sec.	S___ T___ R___	
	S___ T___ R___	

4. Lot No. _____, Recorded Plat _____
5. Private Claims _____

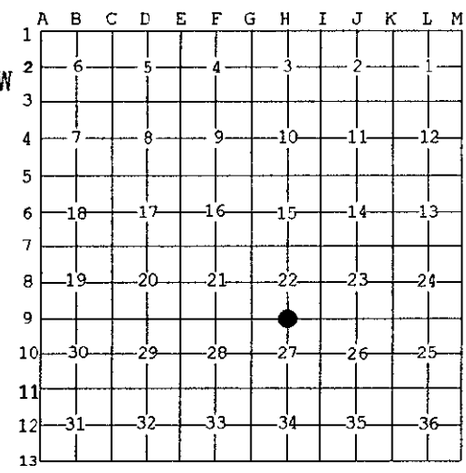

Quarter corner, Common to Sections 22 & 27, T47N,R44W

I, John P. Goss, in a field survey on June 29 1998 do hereby state that under requirements of P.A. 74, Michigan P.A. of 1970, the corner points mentioned in lines 1 and 2 above were in conformance with regulations and rules therefore as required in the current manual of survey instructions of the United States Department of the Interior, Bureau of Land Management or by a decree of a Court of Law and /or that the corner points mentioned in lines 3, 4 and 5 above were in conformance with the rules of the Michigan Board of Land Surveyors or by a Decree of a Court of Law; established, re-established, monumented, recovered, found as expressed below:

NOTE: Not more than 2 corners, all in the same town and range, may be recorded on this certificate.

A. Description of original monument and accessories and/or subsequent restoration:
Corner established by William Burt, U.S. Deputy Surveyor, in 1848.
Original bearing trees: Hemlock 20" N 60° E 8 links
Fir 6" S 50° W 20 links
On October 22, 1970, Donald D. Lappala, RLS, USFS, restored corner position at recordbearing and distance from the hemlock bearing tree and natural feature ties. He set a 2½" dia. galv. iron pipe with 3" circular bronze tablet which reads: T.47 N., R.44 W.; 1/4; S-22, S-27; R.L.S. 12585; 1970, from which he established the following reference objects: 10" Sugar Maple - N 22° E -4.0'; 11" Yellow Birch - S 21° E - 26.8' (now down tree); 8" Sugar Maple- S 55° W - 23.7'

B. Description of corner evidence found and/or method applied in restoring or reestablishing corner:
In 1993, John Garske added a 6" Sugar Maple - South - 46.58'
This corner is recorded in U.S. Forest Service, Liber R-15 on August 10, 1972.
No original evidence was found.
Found Lappala Monument and witnesses trees. Also Garske witness tree.
I updated the monument and accessories as noted below to state and county specification.
Act 74 research on file.

PEER GROUP APPROVED
Richard L. Drake 7/22/98
COUNTY REPRESENTATIVE

C. Description of monument for corner and accessories established to perpetuate locating the position of the corner:
From the found monument I established the existing and new reference objects:

14" Sugar Maple	N 22° E	3.98'
12" Sugar Maple	S 55° W	23.59'
10" Sugar Maple	S 07° W	46.58'
6' rail & Sign	N 50° W	1.47' to face

(All measurements taken to nail in side of tree)

STATE OF MICHIGAN
JOHN P. GOSS
LAND SURVEYOR
No. 23509
REGISTERED LAND SURVEYOR

Signed by John P. Goss Date June 29, 1998
Surveyor's Michigan License No. 23509
U.S.F.S. No. R-15

FORM APPROVED BY MICHIGAN STATE BOARD OF PROFESSIONAL SURVEYORS, JAN. 28, 1971
REVISED MAY 14,1975
REVISED JAN., 1983
REVISED OCT., 1995