

SURVEY &
REMONUMENTATION

SEP 08 1998

LAND CORNER RECORDATION CERTIFICATE
Filing Requirement of Act 74, Mich. P.A. 1970

Register's Office }
Gogebic County } ss.

For corners in SECTION

<u>Gogebic</u> (County)	Located In:	Corner Code #
1. Public Land Survey	T <u>47N</u> R <u>44W</u>	<u>I-3</u>
	T _____ R _____	_____
	T _____ R _____	_____
	T _____ R _____	_____
2. Property Controlling in Section	S _____ T _____ R _____	_____
	S _____ T _____ R _____	_____
3. Miscellaneous Property in Sec.	S _____ T _____ R _____	_____
	S _____ T _____ R _____	_____

Received for record the
14th day of MAY
A. D. 1998 at 3:20 o'clock
P m., and recorded in
Liber 6 of CORNERS
on page 363
Ramona Collins, Deputy
Register of Deeds
Register of Deeds Stamp & File Number

4. Lot No. _____, Recorded Plat _____
5. Private Claims _____

Section Corner 2, 3, 10 & 11; T.47 N., R.44 W.

I, Richard L. Drahn in a field survey on April 24, 1998, do hereby certify that under requirements of P.A. 74, Michigan P.A. of 1970, the corner points mentioned in lines 1 and 2 above were in conformance with regulations and rules therefore as required in the current manual of survey instructions of the United States Department of the Interior, Bureau of Land Management or by a decree of a Court of Law and/or that the corner points mentioned in lines 3, 4 and 5 above were in conformance with the rules of the Michigan Board of Land Surveyors or by a Decree of a Court of Law; established, re-established, monumented, re-monumented, recovered, found as expressed below:

A	B	C	D	E	F	G	H	I	J	K	L	M
2	6	5	4	3	2	1						
3								●				
4	7	8	9	10	11	12						
5												
6	18	17	16	15	14	13						
7												
8	19	20	21	22	23	24						
9												
10	30	29	28	27	26	25						
11												
12	31	32	33	34	35	36						

NOTE: Not more than 4 corners, all in the same town and range, may be recorded on this certificate.

A. Description of original monument and accessories and/or subsequent restoration:

Corner established by William Burt in 1848. Original B.T.s --- Cedar 14" S.60 E. 15 links (9.90') --- W. Ash 8" N.25 W. 15 links (9.90') ---
Corner restored by Richard L. Drahn (21564) on 9/24/75, from the remains of the two original B.T.s and from natural feature ties N, S & W. He set a 2" X 60" iron pipe with a 3" stamped brass cap and the following new B.T.s:

5"	Black Ash	N.05 W.	40.7'
9"	Cedar	S.17 E.	31.6'
11"	Yellow Birch	S.68 W.	56.5'
7"	Steel sign rail	S.45 W.	2.2'

Corner recorded in Gogebic County Liber 1, Page 162 on 1/27/76.

B. Description of corner evidence found and/or method applied in restoring or reestablishing corner:

Corner research on file with Gogebic County records.

Recovered the monument as described and the bearing trees as follows:

7"	Black Ash	N.06 W.	40.65' (new nail)
11"	Cedar	S.16 E.	31.68' " "
12"	Y. Birch (dead)	S.68 W.	56.37' " "
7"	Steel sign rail	S.46 W.	2.16'


Portions of the two original bearing trees are still evident.

C. Description of monument for corner and accessories established to perpetuate locating the position of the corner:

New bearing objects referenced:

6"	Black Ash	N.68 E.	12.68' (near dead, USFS 11/7/90)
6"	Black Ash	S.67 W.	35.17'

PEER GROUP APPROVAL
Richard L. Drahn 5/13/98
COUNTY REGISTER

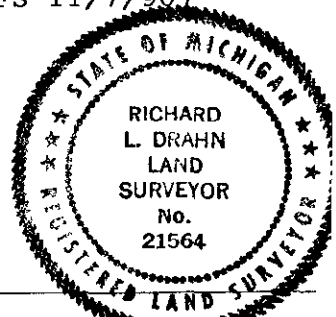

Signed by Richard L. Drahn Date May 4, 1998

Surveyor's Michigan License No. 21564