

SURVEY &
REMONUMENTATION

SEP 08 1998

LAND CORNER RECORDATION CERTIFICATE
Filing Requirement of Act 74, Mich. P.A. 1970

Register's Office }
Gogebic County } ss.

Received for record the
14TH day of MAY
A. D. 1998 at 3:20 o'clock
P m., and recorded in
Liber 6 of CORNERS
on page 365
Ramona Colman, Deputy
Register of Deeds

Register of Deeds Stamp & File Number

SECTION

For corners in

<u>Gogebic</u> (County)	Located In:	Corner Code #
1. Public Land Survey	T <u>47N</u> R <u>44W</u>	<u>I-5</u>
	T _____ R _____	_____
	T _____ R _____	_____
	T _____ R _____	_____
2. Property Controlling in Section	S _____ T _____ R _____	_____
	S _____ T _____ R _____	_____
3. Miscellaneous Property in Sec.	S _____ T _____ R _____	_____
	S _____ T _____ R _____	_____

4. Lot No. _____, Recorded Plat _____
5. Private Claims _____

Section Corner 10, 11, 14 & 15; T.47 N., R.44 W.

I, Richard L. Drahn in a field survey on April 24, 1998, do hereby certify that under requirements of P.A. 74, Michigan P.A. of 1970, the corner points mentioned in lines 1 and 2 above were in conformance with regulations and rules therefore as required in the current manual of survey instructions of the United States Department of the Interior, Bureau of Land Management or by a decree of a Court of Law and/or that the corner points mentioned in lines 3, 4 and 5 above were in conformance with the rules of the Michigan Board of Land Surveyors or by a Decree of a Court of Law; established, re-established, monumented, re-monumented, recovered, found as expressed below:

NOTE: Not more than 4 corners, all in the same town and range, may be recorded on this certificate.

	A	B	C	D	E	F	G	H	I	J	K	L	M
2	6	5	4	3	2	1							
3													
4	7	8	9	10	11	12							
5													
6	18	17	16	15	14	13							
7													
8	19	20	21	22	23	24							
9													
10	30	29	28	27	26	25							
11													
12	31	32	33	34	35	36							

A. Description of original monument and accessories and/or subsequent restoration:

Corner established by William Burt in 1848. Original B.T.s --- Cedar 12" N.50 W. 4 links (2.64') --- Cedar 12" S.15 E. 20 links (13.20') ---

Corner restored at the location of the original Cedar post point by Donald D. Lappala (12585) on 6/24/74. The remains of both bearing trees were recovered at record bearing and distance from the original post point. He set a 2" X 60" iron pipe with a 3" stamped brass cap and the following:

8"	Cedar	N.54 W.	11.0'
10"	Cedar	S.60 E.	12.8'
6"	Yellow Birch	S.09 W.	23.0'

B. Description of corner evidence found and/or method applied in restoring or reestablishing corner:

Corner recorded in Gogebic County USFS Liber, Page J-17 on 3/4/75.

Corner research on file with Gogebic County records.

Recovered the monument as described and the bearing trees as follows:

9"	Cedar	N.53 W.	10.67'	(new nail)
12"	Cedar	S.59 E.	13.07'	" "
8"	Yellow Birch	S.09 W.	22.70'	" "


The original Cedar at N.50 W. is now a large windthrown Cedar with GLO blazes. The Cedar at S.15 E. is now a decayed Cedar windfall.

C. Description of monument for corner and accessories established to perpetuate locating the position of the corner:

New bearing object referenced:

6' Steel sign rail S.06 E. 3.14'

REER GROUP APPROVAL
Richard L. Drahn 5/13/98
COUNTY REGISTERING

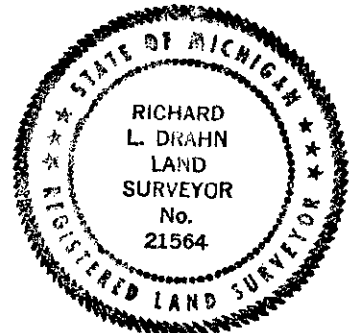

Signed by Richard L. Drahn Date May 4, 1998

Surveyor's Michigan License No. 21564