

SURVEY & REMONUMENTATION

SEP 08 1998

LAND CORNER RECORDATION CERTIFICATE
Filing Requirement of Act 74, Mich. P.A. 1970

Register's Office }
Gogebic County } ss.

For corners in SECTION

Gogebic
(County)

Located In: Corner Code #


- | | | | |
|------------------------------------|-------|-----------------------------|-----|
| 1. Public Land Survey | | T <u>47</u> N R <u>44</u> W | I-9 |
| | | T ___ R ___ | ___ |
| | | T ___ R ___ | ___ |
| | | T ___ R ___ | ___ |
| 2. Property Controlling in Section | S ___ | T ___ R ___ | ___ |
| | S ___ | T ___ R ___ | ___ |
| 3. Miscellaneous Property in Sec. | S ___ | T ___ R ___ | ___ |
| | S ___ | T ___ R ___ | ___ |

Received for record the
23rd day of JULY
A. D. 1998 at 11:35 o'clock
A m., and recorded in
Liber 7 of CORNER
on page 23
Ramona Collins Deputy
Register of Deeds

Register of Deeds Stamp & File Number

4. Lot No. _____, Recorded Plat _____
5. Private Claims _____

Section Corner, Sections 22, 23, 26 & 27, T47N, R44W

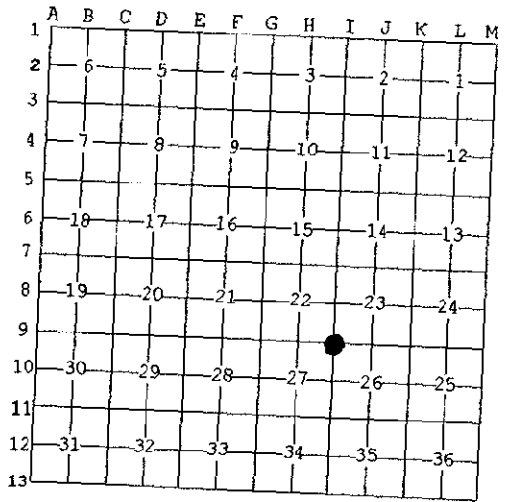

I, John P. Goss, in a field survey on June 19, 1998 do hereby state that under requirements of P.A. 74, Michigan P.A. of 1970, the corner points mentioned in lines 1 and 2 above were in conformance with regulations and rules therefore as required in the current manual of survey instructions of the United States Department of the Interior, Bureau of Land Management or by a decree of a Court of Law and for that the corner points mentioned in lines 3, 4 and 5 above were in conformance with the rules of the Michigan Board of Land Surveyors or by a Decree of a Court of Law; established, re-established, monumented, recovered, found as expressed below:

NOTE: Not more than 2 corners, all in the same town and range, may be recorded on this certificate.

FIELD GROUP APPROVED
Richard L. Drabin 7/22/98
COURT REPRESENTATIVE

A. Description of original monument and accessories and/or subsequent restoration:
Corner established by William Burt, U.S. Deputy Surveyor, in 1848.
Original bearing trees: Sugar Maple 12" S 60° W 30 links
Sugar Maple 12" N 47° E 32 links
On June 11, 1971, Donald D. Lappala, R.L.S., USFS, restored corner position from remains of the two original bearing trees. He set a 2½" galv. iron pipe with 3" bronze tablet, stamped to indicated corner position. He established the following reference objects:
7" Sugar Maple - S 45° E - 34.0'
10" Elm - S 15° E - 7.1' (dead) 5" Sugar Maple - N 60° E - 12.8' (dead)
4"x4"x7' cedar sign post - N 48° W - 3.1'

B. Description of corner evidence found and/or method applied in restoring or reestablishing corner:
In 1992 John Garske, R.L.S. 28410 established two more reference objects:
6" Maple - N 23° W - 22.25' 6" Maple - N 75° E - 28.80'
This corner is recorded in U.S. Forest Service Liber R-17 on August, 1972.
Found some of Donald Lappala and John Garske witnesses and Lappala monument.
No original evidence was found.
I updated the monument and accessories as noted below to state and county specification.
Act 74 research on file.

C. Description of monument for corner and accessories established to perpetuate locating the position of the corner:
From found 2½" galv. iron pipe with 3" circular bronze tablet which reads:
T.47 N., R.44 W.; S-22, S-23, S-26, S-27; R.L.S. 12585; 1971, from which I established the following existing and new reference objects.
10" Sugar Maple S 45° W 33.90' new nail
7" Maple N 23° W 22.25'
9" Maple N 75° E 28.80'
10" Maple S 26° E 31.69'
4"x4"x7' Cedar sign post N 48° W 3.1' to face
(All measurement taken to nail in side of tree)

Signed by John P. Goss
Surveyor's Michigan License No. 23509

Date June 19, 1998



U.S.F.S. No. R-17