

SURVEY & REMONUMENTATION

OCT 03 1996

COMMISSION

LAND CORNER RECORDATION CERTIFICATE
Filing Requirement of Act 74, Mich. P.A. 1970

Register's Office }
 Gogebic County } ss.

Received for record the
10TH day of JUNE
 A. D. 1996 at 10:00 o'clock
0 m., and recorded in
 Liber 5 of CORNER
 page 385
Ramona Collins, Deputy
 Register of Deeds

Register of Deeds Stamp & File Number

For corners in

Gogebic
 (County)

Located In: _____ Corner Code #/

1. Public Land Survey

T 47N R 44W. I-13
T 46N R 44W. I-1

2. Property Controlling in Section

S _____ T _____ R _____
 S _____ T _____ R _____

3. Miscellaneous Property in Sec.

S _____ T _____ R _____
 S _____ T _____ R _____

4. Lot No. _____, Recorded Plat _____
 5. Private Claims _____

Sec. Cor. 34, 35, 2 & 3; T.46-47 N., R.44 W.

I, Richard L. Drahn in a field survey on May 27, 1996, do hereby certify that under requirements of P.A. 74, Michigan P.A. of 1970, the corner points mentioned in lines 1 and 2 above were in conformance with regulations and rules therefore as required in the current manual of survey instructions of the United States Department of the Interior, Bureau of Land Management or by a decree of a Court of Law and/or that the corner points mentioned in lines 3, 4 and 5 above were in conformance with the rules of the Michigan Board of Land Surveyors or by a Decree of a Court of Law, established, re-established, monumented, re-monumented, recovered, found as expressed below:

	A	B	C	D	E	F	G	H	J	K	L	M
2	6	5	4	3	2	1						
3												
4	7	8	9	10	11	12						
5												
6	18	17	16	15	14	13						
7												
8	19	20	21	22	23	24						
9												
10	30	29	28	27	26	25						
11												
12	31	32	33	34	35	36						
13												

NOTE: Not more than 4 corners, all in the same town and range, may be recorded on this certificate.

A. Description of original monument and accessories and/or subsequent restoration:

Corner established by William Burt in 1848. Original B.T.s --- Y. Birch 22" N.78 E. 24 links (15.84') --- Hemlock 16" N.55 W. 23 links (15.18') Original B.T.s by Austin Burt on August 19, 1851 --- fir 14" S.12 W. 12 links (7.92') --- Fir 14" S.33 E. 14 links (9.24') --- Corner restored by Donald D. Lappala, RLS 12585 on 10/13/69 from the remains of the 1848 bearing trees and the stump holes of the 1851 B.T.s and from natural features west and north. He set a 2½" iron pipe monument with a 3" stamped brass cap and the following new bearing trees: 8" (12") Spruce N.89 W. (N.87 W.) 38.8' (38.79' slope distance) --- 12" (17") Spruce N.65 E. (N68 E.)

B. Description of corner evidence found and/or method applied in restoring or reestablishing corner:

20.2' (20.04') --- 4" (11") Sugar Maple S.36 W. (S.37 W.) 23.2' (23.23') --- Corner recorded in Gogebic County in USFS Liber, Page Z-17 on 5/27/96. Act 74 research form on file with Gogebic County records.


Recovered the monument as described and the bearing objects as noted in parentheses above. Only depressions remain from the original bearing trees.

PEER GROUP APPROVED
Richard L. Drahn 6/6/96
 COUNTY REPRESENTATIVE

C. Description of monument for corner and accessories established to perpetuate locating the position of the corner:

Bearing objects referenced:

4" X 4" Cedar sign post N.57 W. 1.85'
 6' Steel sign rail S.65 E. 3.0'

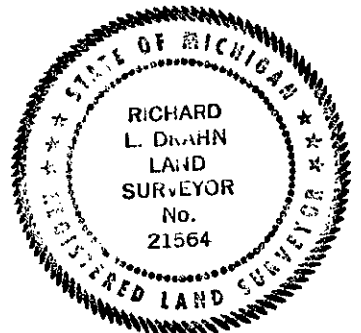

Signed by Richard L. Drahn

Date May 29, 1996

Surveyor's Michigan License No. 21564