

SURVEY & MONUMENTATION

OCT 03 1996

COMMISSION

LAND CORNER RECORDATION CERTIFICATE
Filing Requirement of Act 74, Mich. P.A. 1970

Register's Office }
 Gogebic County } ss.

Received for record the
10th day of JUNE
 A. D. 1996 at 10:00 o'clock
0 m., and recorded in
 Liber 5 of CORNERS
 on page 387
Ramona Collins Deputy
 Register of Deeds

Register of Deeds Stamp & File Number

For corners in

Gogebic
 (County)

Located In:

Corner Code #/

1. Public Land Survey

T 47N R 44W J-13
T 46N R 44W J-1

2. Property Controlling in Section

S ___ T ___ R ___
 S ___ T ___ R ___

3. Miscellaneous Property in Sec.

S ___ T ___ R ___
 S ___ T ___ R ___

4. Lot No. _____, Recorded Plat _____
 5. Private Claims _____

$\frac{1}{4}$ Corner 35 & 2; T.46-47 N., R.44 W.

I, Richard L. Drahn in a field survey on May 27, 19 96, do hereby certify that under requirements of P.A. 74, Michigan P.A. of 1970, the corner points mentioned in lines 1 and 2 above were in conformance with regulations and rules therefore as required in the current manual of survey instructions of the United States Department of the Interior, Bureau of Land Management or by a decree of a Court of Law and/or that the corner points mentioned in lines 3, 4 and 5 above were in conformance with the rules of the Michigan Board of Land Surveyors or by a Decree of a Court of Law; established, re-established, monumented, re-monumented, recovered, found as expressed below:

NOTE: Not more than 4 corners, all in the same town and range, may be recorded on this certificate.

A. Description of original monument and accessories and/or subsequent restoration:

Corner established by Austin Burt on August 27, 1847. Original B.T.s--- Sugar 8" N.35 E. 29 links (19.14') --- Y. Birch 10" N.40 W. 31 links (20.46') --- Corner restored by Donald D. Lappala, RLS 12585 on 6/8/71 from the remains of the original bearing trees. He set a 2" iron pipe with a 3" stamped brass cap and the following new bearing trees --- 10" (8") Sugar Maple N.05 E. (N.05 E.) 12.0' (12.05') --- 9" (9") Sugar Maple S.54 E. (S.51 E.) 11.2' (11.18') --- 7" (7") Y. Birch S.40 W. (S.39 W.) 8.9' (8.97') --- 4" X 4" Cedar sign post s.78 E. (S.79 E.) 2.6' (2.6')

Corner recorded in Gogebic County in USFS Liber, Page Z-19 on 8/10/72.

B. Description of corner evidence found and/or method applied in restoring or reestablishing corner:

Act 74 research form on file with Gogebic County records.

Recovered the monument as described and the bearing objects as noted in parentheses above.

A depression remains from the original Sugar bearing tree.

	A	B	C	D	E	F	G	H	I	J	K	L	M
2	6	5	4	3	2	1							
3													
4	7	8	9	10	11	12							
5													
6	18	17	16	15	14	13							
7													
8	19	20	21	22	23	24							
9													
10	30	29	28	27	26	25							
11													
12	31	32	33	34	35	36							
13													


PEER GROUP APPROVED

Richard L. Drahn 6/6/96
 COUNTY REPRESENTATIVE

C. Description of monument for corner and accessories established to perpetuate locating the position of the corner:

Bearing objects referenced:

6' Steel sign rail N.86 W. 3.15'

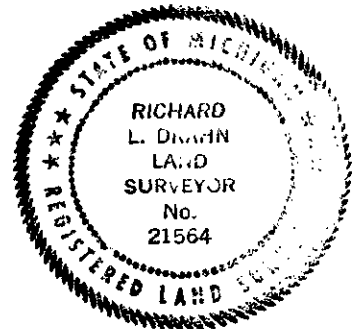

Signed by Richard L. Drahn

Date May 29, 1996

Surveyor's Michigan License No. 21564