

SURVEY &  
REMONUMENTATION

SEP 08 1998

SECTION

LAND CORNER RECORDATION CERTIFICATE  
Filing Requirement of Act 74, Mich. P.A. 1970

Register's Office }  
Gogebic County } SS.

For corners in

Gogebic  
(County)

Located In:

Corner Code #

- |                                    |                             |       |
|------------------------------------|-----------------------------|-------|
| 1. Public Land Survey              | T <u>47</u> N R <u>44</u> W | K-9   |
|                                    | T ___ R ___                 | _____ |
|                                    | T ___ R ___                 | _____ |
|                                    | T ___ R ___                 | _____ |
| 2. Property Controlling in Section | S ___ T ___ R ___           | _____ |
|                                    | S ___ T ___ R ___           | _____ |
| 3. Miscellaneous Property in Sec.  | S ___ T ___ R ___           | _____ |
|                                    | S ___ T ___ R ___           | _____ |

Received for record the  
23<sup>RD</sup> day of JULY  
A. D. 1998 at 11:35 o'clock  
A m., and recorded in  
Liber 7 of CORNERS  
on page 26  
Ramona Collins Deputy  
Register of Deeds

Register of Deeds Stamp & File Number

4. Lot No. \_\_\_\_\_, Recorded Plat \_\_\_\_\_  
5. Private Claims \_\_\_\_\_

Section Corner common to Sec's. 23, 24, 25, 26, T47N, R44W

I, John P. Goss, in a field survey on June 30, 1998 do hereby state that under requirements of P.A. 74, Michigan P.A. of 1970, the corner points mentioned in lines 1 and 2 above were in conformance with regulations and rules therefore as required in the current manual of survey instructions of the United States Department of the Interior, Bureau of Land Management or by a decree of a Court of Law and/or that the corner points mentioned in lines 3, 4 and 5 above were in conformance with the rules of the Michigan Board of Land Surveyors or by a Decree of a Court of Law, established, re-established, monumented, recovered, found as expressed below:

1	A	B	C	D	E	F	G	H	I	J	K	L	M
2		6		5		4		3		2		1	
3													
4		7		8		9		10		11		12	
5													
6		18		17		16		15		14		13	
7													
8		19		20		21		22		23		24	
9													
10		30		29		28		27		26		25	
11													
12		31		32		33		34		35		36	
13													

NOTE: Not more than 2 corners, all in the same town and range, may be recorded on this certificate.

A. Description of original monument and accessories and/or subsequent restoration:

Corner established by William Burt, U.S. Deputy Surveyor, in 1848.

Original bearing trees: Sugar Maple 14" - N 20° E - 38 links (25.08')

Sugar Maple 12" - S 25° W - 33 links (21.78')

On June 11, 1971, Donald D. Lappala, RLS, USFS, restored corner position at record bearing and distance from the stump holes of the two original bearing trees and natural feature ties. He set a 2½" dia, galv. iron pipe with 3" circular bronze tablet which reads: T.47N., R.44 W.; S-23, S-24, S-25, S-26; R.L.S. 12585; 1971, from which he established the following reference objects: 9" Elm - N 58° W - 25.7' (out); 14" Elm - S 45° W - 28.4' (dead)

B. Description of corner evidence found and/or method applied in restoring or reestablishing corner:

4" by 4" Cedar sign post - S 44° W - 2.8'; A Water Well pump - S 61° E - 44.1' He recorded said corner in U.S. Forest Service Liber R-21 on August 11, 1972. No original evidence was found.

Found Lappala, monument and two (2) witnesses.

I updated the monument and accessories as noted below to state and county specification.

Act 74 research on file.


PEER GROUP APPROVED  
Richard L. Dean 7/22/98  
COUNTY REGISTER

C. Description of monument for corner and accessories established to perpetuate locating the position of the corner:

From the found monument I established the existing and new reference objects.

- |                          |         |        |         |
|--------------------------|---------|--------|---------|
| Water Well pump          | S 61° E | 44.1'  | to face |
| 4" by 4" Cedar sign post | S 44° W | 2.77'  | to face |
| 12" Maple                | N 37° W | 17.06' |         |
| 8" Maple                 | S 79° W | 12.11' |         |
| 5" Balsam                | S 68° E | 16.31' |         |

(All measurement taken to nail in side of tree)

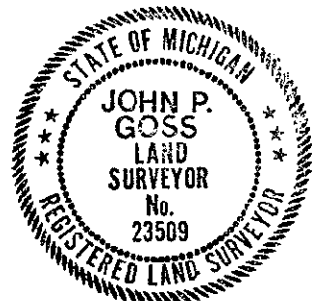

Signed by John P. Goss  
Surveyor's Michigan License No. 23509

Date June 30, 1998

U.S.F.S. No. R-21