SURVEY & REMONUMENTATION

SEP 0 8 1998

SECTION

LAND CORNER RECORDATION CERTIFICATE
Filing Requirement of Act 74, Mich. P.A. 1970

Register's Office } ss.
Gogebic County }

Received for record the 14TH day of MAY A. D. 1998 at 3:20 o'clock P m., and recorded in Liber 6 of CORNERS on page 377

Ramona Collins Deputy
Register of Deeds

Register of Deeds Stamp & File Number

For corners in Gogebic (County)

	Located in:	Corner Code ##
1. Public Land Survey	T 47N R 44W	L-1
	R	
	T R	
	T R	
2. Property Controlling	S T 48N R 44W	L-13
in Section	S T R	
3. Miscellaneous	S T R	
Property in Sec.	S T R	

4. Lot No. _____, Recorded Plat _____
5. Private Claims _____

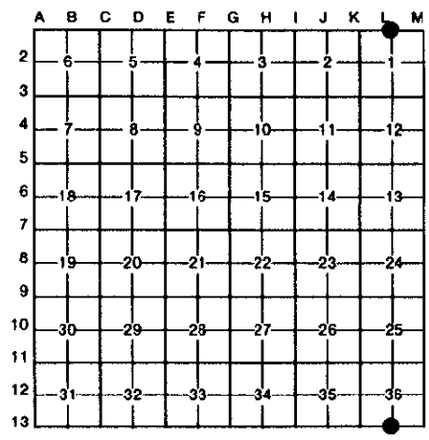

¼ Corner 1 & 36; T.47-48 N., R.44 W.

I, Richard L. Drahn in a field survey on April 29, 19 98, do hereby certify that under requirements of P.A. 74, Michigan P.A. of 1970, the corner points mentioned in lines 1 and 2 above were in conformance with regulations and rules therefore as required in the current manual of survey instructions of the United States Department of the Interior, Bureau of Land Management or by a decree of a Court of Law and/or that the corner points mentioned in lines 3, 4 and 5 above were in conformance with the rules of the Michigan Board of Land Surveyors or by a Decree of a Court of Law; established, re-established, monumented, re-monumented, recovered, found as expressed below:

NOTE: Not more than 4 corners, all in the same town and range, may be recorded on this certificate.

A. Description of original monument and accessories and/or subsequent restoration:

Corner established by Austin Burt on 8/11/1847. Original B.T.s --- Fir 7" N.19 E. 45 links (29.70') --- Fir 9" N.17 W. 28 links (18.48') ---
Corner restored by Donald D. Lappala (12585) on 9/27/72 from the stumps of the two original B.T.s, a natural feature tie east and a recovered line tree west. He set a 2" X 60" iron pipe with a 3" stamped brass cap and;

5"	Red Maple	N.04 E.	14.7'
8"	Black Spruce	S.19 E.	63.8'
8"	Black Spruce	S.66 W.	49.7'
7'	Steel sign rail	N.11 W.	2.5'

Corner recorded in Gogebic County USFS Liber, Page Z-23 on 12/9/74.

B. Description of corner evidence found and/or method applied in restoring or reestablishing corner:

Corner research on file with Gogebic County records.

Recovered the monument as described and the bearing trees as follows:

12"	Red Maple	N.06 E.	14.60' (new nail)
10"	Black Spruce	S.20 E.	dead and down
10"	black Spruce	S.64 W.	49.34' (new nail)
7'	Steel sign rail	S.08 W.	2.52'

No evidence remains of the original B.T.s.

C. Description of monument for corner and accessories established to perpetuate locating the position of the corner:

New bearing tree established:

10"	Red Maple	S.03 W.	43.89'

PEER GROUP APPROVAL
Richard L. Drahn 5/13/98
COUNTY REPRESENTATIVE

STATE OF MICHIGAN
RICHARD L. DRAHN LAND SURVEYOR No. 21564
REGISTERED LAND SURVEYOR

Signed by Richard L. Drahn Date May 3, 1998

Surveyor's Michigan License No. 21564

FORM APPROVED BY MICHIGAN STATE BOARD OF LAND SURVEYORS, JAN. 28, 1971
REVISED MAY 14, 1975
REVISED JAN., 1983