

LAND CORNER RECORDATION CERTIFICATE
 Filing Requirement of Act 74, Mich. P.A. 1970

Register's Office }
 Gogebic County } ss.

For corners in
Gogebic
 (County)

Received for record the
16th day of MARCH
 A. D. 1993 at 1:45 o'clock
P m., and recorded in
 Liber 4 of CORNERS
 on page 230.
Betty Harris Deputy
 Register of Deeds

	Located In:	Corner Code #
1. Public Land Survey SECTION 24	T <u>47N</u> R <u>44W</u>	<u>L-9</u>
	T _____ R _____	_____
	T _____ R _____	_____
	T _____ R _____	_____
2. Property Controlling in Section	S _____ T _____ R _____	_____
	S _____ T _____ R _____	_____
3. Miscellaneous Property in Sec.	S _____ T _____ R _____	_____
	S _____ T _____ R _____	_____

Register of Deeds Stamp & File Number

PEER GROUP Approved

4. Lot No. _____, Recorded Plat _____
 5. Private Claims Richard P. Dredman 1/20/94
 1/4 corner to Sections 24 & 25, T47N, R44W.

	A	B	C	D	E	F	G	H	I	J	K	L	M
2	6	5	4	3	2	1							
3													
4	7	8	9	10	11	12							
5													
6	18	17	16	15	14	13							
7													
8	19	20	21	22	23	24							
9													
10	30	29	28	27	26	25							
11													
12	31	32	33	34	35	36							
13													

I, John R. Garske, in a field survey on January, 1993, do hereby certify that under requirements of P.A. 74, Michigan P.A. of 1970, the corner points mentioned in lines 1 and 2 above were in conformance with regulations and rules therefore as required in the current manual of survey instructions of the United States Department of the Interior, Bureau of Land Management or by a decree of a Court of Law and/or that the corner points mentioned in lines 3, 4 and 5 above were in conformance with the rules of the Michigan Board of Land Surveyors or by a Decree of a Court of Law; established, re-established, monumented, re-monumented, recovered, found as expressed below:

NOTE: Not more than 4 corners, all in the same town and range, may be recorded on this certificate.

A. Description of original monument and accessories and/or subsequent restoration:

Original survey by William Burt, Deputy Surveyor, 1848.
 Original Bering Trees:

Set cedar post from which:
 Sugar 10" - S10°E - 8 links
 Sugar 20" - S25°W - 27 links

B. Description of corner evidence found and/or method applied in restoring or reestablishing corner:

I set a math position by single proportional measurement from which to search. No evidence of the original corner position could be found and no evidence of subsequent corner restoration. I monumented the proportioned location after a search of the area.


C. Description of monument for corner and accessories established to perpetuate locating the position of the corner:

I set a 2 1/2" x 30" aluminum monument with a 3" diameter aluminum cap stamped to read: 1/4 cor., S-24; S-25; T47N, R44W; 1993; RLS 28410, from which I established the following bearing trees and/or reference objects:

8" sugar - S89°W - 11.24 feet
 6" sugar - N32°E - 7.17 feet
 12" sugar - S25°E - 11.27 feet
 Steel sign post - S05°W - 2.70 feet

Signed by John R. Garske
 Surveyor's Michigan License No. 28410

Date 3/9/93

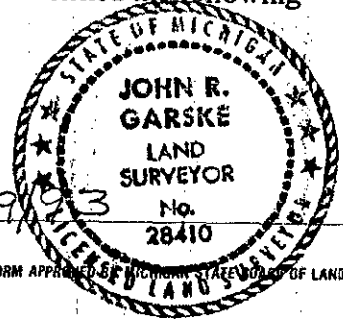

11500 # R-72 230