


LAND CORNER MONUMENTS

JAN 20 1999

SECTION

T. 47 N., R. 44 W.

WAKEFIELD TOWNSHIP

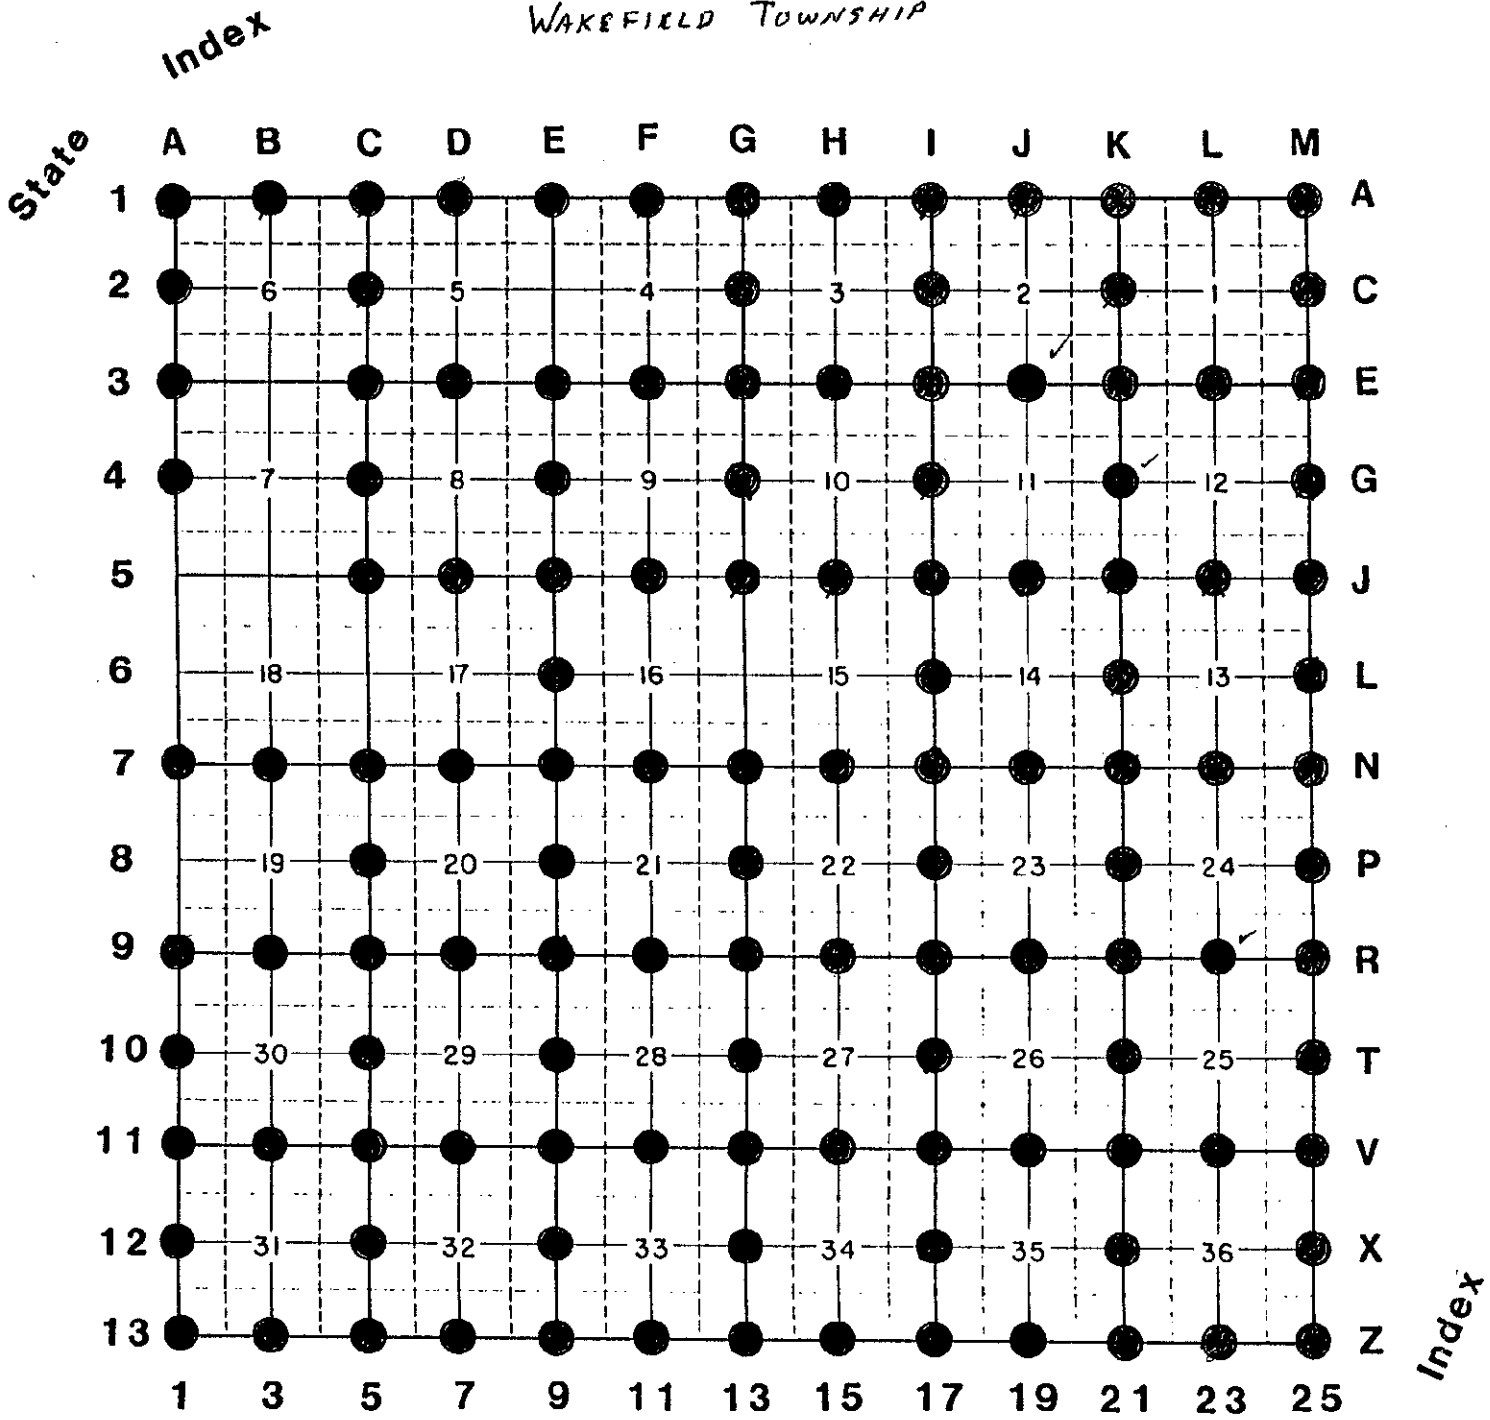

AS OF 12/31/98

LEGEND

Federal

- GLO Corners researched
- ⊙ GLO Corners monumented, not approved
- ⊗ GLO Corners approved
- GLO Corners approved & reported to State

T. 47 N., R. 44 W.