

LAND CORNER RECORDATION CERTIFICATE
Filing Requirement of Act 74, Mich. P.A. 1970

Register's Office }
 Gogebic County } ss.

For corners in
Gogebic
 (County)

Located In: _____ Corner Code # _____

Received for record the
12th day of MAY
 A. D. 1995 at 11:20 o'clock
A m., and recorded in
 Liber 5 of CORNERS
 on page 256.

Ramona Collins Deputy
 Register of Deeds

Register of Deeds Stamp & File Number

- | | | |
|------------------------------------|---------------------------|-----|
| 1. Public Land Survey | T <u>47N</u> R <u>46W</u> | M-2 |
| | T _____ R _____ | |
| | T <u>47N</u> R <u>45W</u> | A-2 |
| | T _____ R _____ | |
| 2. Property Controlling in Section | S _____ T _____ R _____ | |
| | S _____ T _____ R _____ | |
| 3. Miscellaneous Property in Sec. | S _____ T _____ R _____ | |
| | S _____ T _____ R _____ | |

4. Lot No. _____, Recorded Plat _____

5. Private Claims _____

E 1/4 Cor. of Sec. 6, T.47 N., R. 46 W.

I, John P. Goss, in a field survey on April 7, 1995, do hereby certify that under requirements of P.A. 74, Michigan P.A. of 1970, the corner points mentioned in lines 1 and 2 above were in conformance with regulations and rules therefore as required in the current manual of survey instructions of the United States Department of the Interior, Bureau of Land Management or by a decree of a Court of Law and/or that the corner points mentioned in lines 3, 4 and 5 above were in conformance with the rules of the Michigan Board of Land Surveyors or by a Decree of a Court of Law; established, re-established, monumented, re-monumented, recovered, found as expressed below:

A	B	C	D	E	F	G	H	I	J	K	L	M
2	6	5	4	3	2	1						
3												
4	7	8	9	10	11	12						
5												
6	18	17	16	15	14	13						
7												
8	19	20	21	22	23	24						
9												
10	30	29	28	27	26	25						
11												
12	31	32	33	34	35	36						
13												

NOTE: Not more than 4 corners, all in the same town and range, may be recorded on this certificate.

A. Description of original monument and accessories and/or subsequent restoration:

Original Survey by John Burt, D.S. in 1847. Set a Ironwood Post. Original Bearing Trees; B. Cherry 6"- S 16°E-15 Links; Spruce 12" N 21°W- 52 links.

Morris R. Price in 1980 set a 5/8 inch iron rebar and recorded this corner in Liber 2 on page 63 of Gogebic County Land Corners: 10" Birch- N 23°E 18.25'; 14" Oak- S 80°E- 15.10'; 12" Maple- S 23°E- 33.40'; 10" Maple- S 56°W-7.42'.

B. Description of corner evidence found and/or method applied in restoring or reestablishing corner:

I found the 5/8 inch rebar marking the corner position and it checked with two of the witnesses in Morris price certificate. (Only two witnesses trees left). I updated the corner monument and accessories as noted below to state and county specification.


Act 74 reseach on file with the County Register of Deeds Office.

PEER GROUP APPROVED
Richard P. Duda 5/11/95
 COUNTY REPRESENTATIVE

C. Description of monument for corner and accessories established to perpetuate locating the position of the corner:

I placed a 2 1/2" x 30" aluminum pipe with a 3 1/4" aluminum cap Stamped as follows over the 5/8 inch iron rebar: County Remonumentation; 1/4; S-1; S-6; T.47 N.; R 46-45 W; 1995; P.S. 23509. I established the following bearing trees and reference objects.

- | | | |
|-----------------|---------|--------|
| 12" Maple | S 56° W | 7.38' |
| 16" Oak | S 80° E | 15.10' |
| T. Pole | Due N. | 66.22' |
| T. Pole | N 71° W | 82.12' |
| Steel Sign Post | N 58° E | 1.08' |

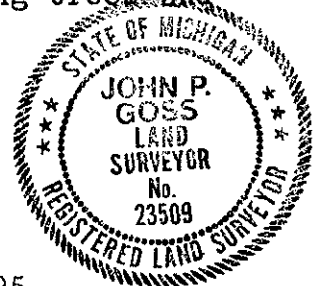

igned by John P Goss Date April 10, 1995

urveyor's Michigan License No. P.S. 23509