

LAND CORNER RECORDATION CERTIFICATE
Filing Requirement of Act 74, Mich. P.A. 1970

Register's Office }
 Gogebic County } ss.

Received for record the
12TH day of MAY
 A. D. 1995 at 11:20 o'clock
A m., and recorded in
Liber 5 of LAND CORNERS

on page 257
Ramona Collins Deputy
 Register of Deeds

Register of Deeds Stamp & File Number

For corners in

Gogebic
 (County)

Located In:

Corner Code #


- | | | |
|------------------------------------|-----------------------------|-------|
| 1. Public Land Survey | T <u>47N</u> R <u>46W</u> | M-3 |
| | T _____ R _____ | |
| | (<u>47N</u> R <u>45W</u>) | (A-3) |
| | T _____ R _____ | |
| 2. Property Controlling in Section | S _____ T _____ R _____ | |
| | S _____ T _____ R _____ | |
| 3. Miscellaneous Property in Sec. | S _____ T _____ R _____ | |
| | S _____ T _____ R _____ | |

4. Lot No. _____, Recorded Plat _____
 5. Private Claims _____

Sec. Cor. Comm. to Sec's. 1,12,6 & 7

I, John P. Goss, in a field survey on May 8, 19 95, do hereby certify that under requirements of P.A. 74, Michigan P.A. of 1970, the corner points mentioned in lines 1 and 2 above were in conformance with regulations and rules therefore as required in the current manual of survey instructions of the United States Department of the Interior, Bureau of Land Management or by a decree of a Court of Law and/or that the corner points mentioned in lines 3, 4 and 5 above were in conformance with the rules of the Michigan Board of Land Surveyors or by a Decree of a Court of Law, established, re-established, monumented, re-monumented, recovered, found as expressed below:

NOTE: Not more than 4 corners, all in the same town and range, may be recorded on this certificate.

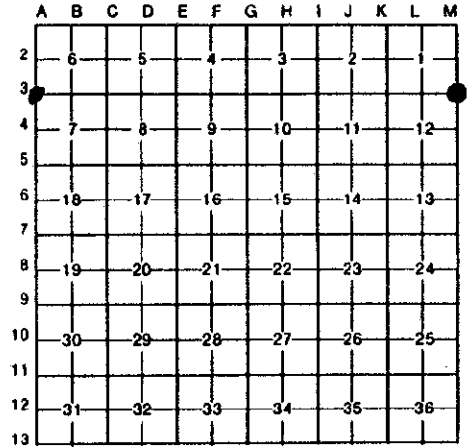

A. Description of original monument and accessories and/or subsequent restoration:
 Original corner established by John Burt, U.S. Deputy Surveyor on September 7, 1847, as being a Cedar post.
 Original Bearing Trees: Spruce 10" S 17° E 38 links
 Fir 8" N 57° W 32 links
 Morris R. Price set this corner and recorded it in 1980 in Liber 2 on pages 65 and 66 of Land Corners; Set 5/8" rebar : 4" Elm- N 18° E-72.40'; 10" Poplar S 80° E- 40.45'; 5" Elm- S 46° W- 62.50'; 10" Poplar- N 88° W- 67.10.


B. Description of corner evidence found and/or method applied in restoring or reestablishing corner:
 Bearing trees from Morris R. Price recording was removed by road and water line construction. I used Morris R. Price recorded survey in Liber 1 page 185 of Survey Maps, I chained South 660 feet from found points and found 5/8" rebar buried 15". I updated the corner monument and accessories as noted below to state and county specification.

Act 74 reseach on file with the County Register of Deeds Office.

PEER GROUP APPROVED
Richard P. Draker 5/11/95
 COUNTY REPRESENTATIVE

C. Description of monument for corner and accessories established to perpetuate locating the position of the corner:
 I placed a 3/4" aluminum cap on the found 5/8 inch rebar, 15" below roadway surface stamed: County Remonumentation; T.47N, R.45-46 W.; S-1; S-12; S-6; S-7; 1995; P.S. 23509. I established the following bearing trees and reference objects.

- | | | |
|--------------------------------|---------|--------|
| D.H. Nail & Tag in Power Pole | N 80° E | 30.82' |
| D.H. Nail & Tag in 7" Ash | S 49° W | 97.52' |
| D.H. Nail & Tag in 4" W. Birch | N 85° W | 80.23' |
- Reference Monument consisting of a 2 1/2" x 30" aluminum monument with a 3/4" aluminum cap stamped to indicate corner position: S 46° E- 24.23' with a 6' steel Rail and Sign 0.97'.

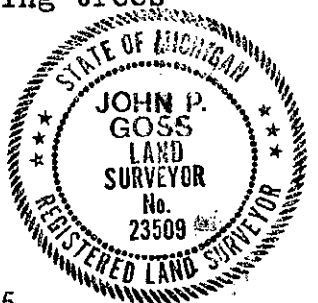

Signed by John P. Goss Date May 9, 1995
 Surveyor's Michigan License No. P.S. 23509

Fed. No. E-25