

LAND CORNER RECORDATION CERTIFICATE
Filing Requirement of Act 74, Mich. P.A. 1970

Register's Office }
 Gogebic County } ss.

Received for record the
16th day of DECEMBER
 A. D. 1994 at 10:45 o'clock
4 m., and recorded in
 Liber 5 of CORNERS
 on page 167.
Ramona Collins Deputy
 Register of Deeds

For corners in

Gogebic
 (County)

Located In: _____ Corner Code # _____

- | | | |
|------------------------------------|---------------------------|-----|
| 1. Public Land Survey | T <u>47N</u> R <u>46W</u> | M-4 |
| | T _____ R _____ | |
| | T <u>47N</u> R <u>45W</u> | A-4 |
| | T _____ R _____ | |
| 2. Property Controlling in Section | S _____ T _____ R _____ | |
| | S _____ T _____ R _____ | |
| 3. Miscellaneous Property in Sec. | S _____ T _____ R _____ | |
| | S _____ T _____ R _____ | |

Register of Deeds Stamp & File Number

4. Lot No. _____, Recorded Plat _____
 5. Private Claims _____

E $\frac{1}{4}$ cor. Sec. 12, T47N, R46W and
W $\frac{1}{4}$ cor. Sec. 7, T47N, R45W

John P. Goss in a field survey on November 4, 1994

do hereby certify that under requirements of P.A. 74, Michigan P.A. of 1970, the corner points mentioned in lines 1 and 2 above were in conformance with regulations and rules therefore as required in the current manual of survey instructions of the United States Department of the Interior, Bureau of Land Management or by a decree of a Court of Law and/or that the corner points mentioned in lines 3, 4 and 5 above were in conformance with the rules of the Michigan Board of Land Surveyors or by a Decree of a Court of Law; established, re-established, monumented, re-monumented, recovered, found as expressed below:

NOTE: Not more than 4 corners, all in the same town and range, may be recorded on this certificate.

	A	B	C	D	E	F	G	H	I	J	K	L	M
2	6		5		4		3		2				
3													
4	7		8		9		10		11		12		
5													
6	18		17		16		15		14		13		
7													
8	19		20		21		22		23		24		
9													
10	30		29		28		27		26		25		
11													
12	31		32		33		34		35		36		
13													

A. Description of original monument and accessories and/or subsequent restoration:

Original survey by John Burt in 1847. Set sugar post

Original bearing trees: Hemlock 10"-S84⁰E-18 links & Fir 14"-N9⁰W-27 links

In 1979 John P. Goss found a 2" iron pipe as witness by MDOT in 1959. I recorded it in Liber 1 of Land Corners on page 410 with the following accessories: 12" Elm-N67⁰E-45.73'; P.Pole-N57⁰W-39.69'; Fence Post-S33⁰W-46.28'.

B. Description of corner evidence found and/or method applied in restoring or reestablishing corner:


Using witness from recorded corner I found 2" iron pipe buried 1' under roadway. I placed a monument box and upgraded the accessories as noted below to State and County specification.

Act 74 research on file with County Register of Deeds Office.

PEER GROUP

Approved

Richard L. Dean 11/30/94

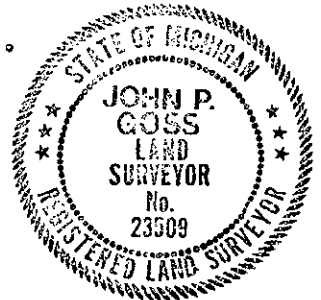

C. Description of monument for corner and accessories established to perpetuate locating the position of the corner:

I placed a 3/4 inch iron rod inside both monument box and 2 inch iron pipe with a 3/4 inch aluminum cap stamed: County Remonumentation, 1/4, S-7, S-12, T.47N., R.46 W., R.45 W., 1994, P.S.23509. I established the following bearing trees and reference objects.

- | | | |
|--------------------------------------------|--------------------|--------|
| D.H. Nail and tag in Dead Elm | N67 ⁰ E | 45.73' |
| D.H. Nail and tag in 10" Y. Birch | S52 ⁰ E | 61.00' |
| D.H. Nail and tag in group of 12" Basswood | N59 ⁰ E | 48.96' |
| D.H. Nail and tag in P.Pole | N57 ⁰ W | 39.69' |
| D.H. Nail and tag in 4" Spruce | S83 ⁰ W | 60.26' |

R.M. #1 consisting of 3/4" dia. by 4' long aluminum rod with a 3/4" aluminum cap stamped to indicated corner position: Due East- 25.87' and steel sign post 0.95 feet away.

Signed by John P Goss

Date 11-29-94

Surveyor's Michigan License No. P.S. 23509

Gogebic County Road Commission