

**LAND CORNER RECORDATION CERTIFICATE**  
**Filing Requirement of Act 74, Mich. P.A. 1970**

Register's Office }  
 Gogebic County } SS.

Received for record the  
21<sup>ST</sup> day of SEPTEMBER  
 A. D. 1995 at 9:55 o'clock  
A m., and recorded in  
5 of CORNERS  
 on page 292  
Ramona Collins, Deputy  
 Register of Deeds

For corners in

<u>Gogebic</u> (County)	Located In:	Corner Code #
1. Public Land Survey	T <u>47N</u> R <u>45W</u>	<u>B-5</u>
	T _____ R _____	_____
	T _____ R _____	_____
	T _____ R _____	_____
2. Property Controlling in Section	S _____ T _____ R _____	_____
	S _____ T _____ R _____	_____
3. Miscellaneous Property in Sec.	S _____ T _____ R _____	_____

Register of Deeds Stamp & File Number

4. Lot No. \_\_\_\_\_, Recorded Plat \_\_\_\_\_  
 5. Private Claims \_\_\_\_\_  
 One quarter corner common to Sections 7 & 18, T47N, R45W

I, John R. Garske, in a field survey on April 23, 1995, do hereby certify that under requirements of P.A. 74, Michigan P.A. of 1970, the corner points mentioned in lines 1 and 2 above were in conformance with regulations and rules therefore as required in the current manual of survey instructions of the United States Department of the Interior, Bureau of Land Management or by a decree of a Court of Law and/or that the corner points mentioned in lines 3, 4 and 5 above were in conformance with the rules of the Michigan Board of Land Surveyors or by a Decree of a Court of Law; established, re-established, monumented, re-monumented, recovered, found as expressed below:

A	B	C	D	E	F	G	H	I	J	K	L	I
2	6	5	4	3	2	1						
3												
4	7	8	9	10	11	12						
5												
6	18	17	16	15	14	13						
7												
8	19	20	21	22	23	24						
9												
10	30	29	28	27	26	25						
11												
12	31	32	33	34	35	36						
13												

**NOTE: Not more than 4 corners, all in the same town and range, may be recorded on this certificate.**

**A. Description of original monument and accessories and/or subsequent restoration:**

In 1848 William Burt set a sugar post from which a 6" sugar bears S45E, 6 links and a 8" sugar-N40W, 23 links. Survey by John R. Garske found a 2" O.D. iron pipe marking the corner position. No original evidence could be found due to logging activity.

**B. Description of corner evidence found and/or method applied in restoring or reestablishing corner:**

Found a 2" O.D. iron pipe marking the corner position on an old fence line. This found corner position is shown on the recorded plat of Assessor's Plat No. 20 (Verona Addition No. 1). The pipe checks well with other points found within the plat and with a proportioned position between existing monumented section corners.


Corner record research on file with County Register of Deeds.

**C. Description of monument for corner and accessories established to perpetuate locating the position of the corner:**

I set a 3 1/4" diameter aluminum cap atop of the existing 2" O.D. iron pipe grouted in concrete. Cap is stamped: T47N, R45W; 1/4; S-7; S-18; 1995, RLS 28410. I established the following bearing trees and/or reference objects:

- 8" maple - N80°E - 6.61 feet
- 9" maple - S17°W - 22.48 feet
- 8" maple - S70°W - 16.03 feet
- 6' steel rail with sign - N25°W - 1.25 feet

**PEER GROUP APPROVED**  
Richard L. Walsh 9/20/95  
 COUNTY REPRESENTATIVE

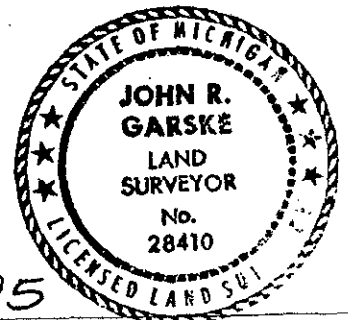

Signed by John R. Garske

Date 9-15-95

Surveyor's Michigan License No. 28410