SURVEY & REMONUMENTATION

SEP 2 9 1994

COMMISSION

LAND CORNER RECORDATION CERTIFICATE Filing Requirement of Act 74, Mich. P.A. 1970

Register's Office	
Register's Office Gogebic County	33.

Received for record the

Fo	or corners i Gogebic					162	4	day						
_		Located In:	Corner Code ##		# I			•						
	(County)				_	D. 19								
1.	Public Land Survey	T <u>47N</u> R <u>45</u> W TR TR	C-2		Libe	r page_	5							
2.	Property Controlling in Section	T R S T R S T R			M	mol	IAI	_	MA giste	,			Ä	
3.	Miscellaneous	S T R	The state of the s	Registe	er of	Deed	is St	amp	& Fi	ile f	Num	sbe		
	Property in Sec.	S T R												
4	Lathia Da	ecorded Plat												
		corded Pial			A B	C	D E	F	G I	н I	1 1	K	L	N
3 .				2	L		<u> </u>	_ _ 4	<u> </u>		2	_		
	One-quarter corne	er common to Section 5) & 6.	3	Ш		$oldsymbol{oldsymbol{oldsymbol{eta}}}$				\Box	_		<u> </u>
	John B. Caroka		June 29 94				8		1	<u>. </u>	<u> </u>	₁╣	—i	2
I, _	bereits and the second second	in a field survey on		, 5	H	+	\vdash	+	╁╾┨	\vdash	┌─┼	┥		-
	do hereby certify that under requirements of P.A. 74, Michigan P.A. of 1970, the corner points mentioned in lines 1 and 2 above were in conformance with regulations and rules therefore as required in the						7	16	1-1	5-	14	 	<u></u> j	3
		ctions of the United States Depart	*	_	\vdash		\vdash	+	╀┤	Н	\dashv	-		┢
	-	Court of Law and/or that the come	•	-	I9	2	-	-21	2	2—	_23	<u>.</u>	<u>z</u>	4
		the rules of the Michigan Board o -established, monumented, re-m	•	q	\vdash		\vdash	┷	\coprod	Ш	$\vdash \vdash$	-		ļ
	pressed below:	Colabiolica, monamenta, von	Torialionida, 10000010a, 10011a	10	30	2	9	28		7	26	,_	<u>2</u>	5
NC	OTF: Not more than 4 co	rners, all in the same town an	id range, may be recorded	11	\Box				$oldsymbol{oldsymbol{\sqcup}}$	Ш		_		
	on this certificate.			12	31			_33			35	↲	3	 6
				13	تـــا		Ī	Ĩ	لـــا		Щ			Ĺ
A.	Description of original m	onument and accessories and	I/or subsequent restoration:					•	•		·			
	- Survey by Wil fir bears N70°E,	liam Burt in 1848, set an ironw , 10 links.	ood post from which a 8" Y. b	oirch bears S	516 ° V	W , 11	link	s and	la l	0 "				

- 1971 Plat of Indian Hills shows corner position.
- 1974 Plat of Indian Hills shows corner position.
- 1981 survey by J. Goss, RLS 23509. Set a 1" square iron pin using found plat monuments. Accessories: P. pole - N77*W, 65.43 feete; 7" oak - N20*E, 97.75 feet; top of hydrant - N87*E, 43.51 feet. Recorded Liber 2 of land corners, page 128.
- To present Several surveys of record by John Garske, P.S., for Indianhead Mt. Ski Corp.
- B. Description of corner evidence found and/or method applied in restoring or reestablishing corner:

1994 survey I found a 1" iron rod marking the corner position which checks with Goss certificate as noted above. I updated the accessories as noted below to bring it up to state and county specificatioins.

Record research on file with County Register of Deeds Office.

C. Description of monument for corner and accessories established to perpetuate locating the position of the corner:

A 1" iron rod marks the corner position. I established the following bearing trees and reference objects: 2 reference monuments consisting of a 2 1/2" x 30" aluminum pipe with a 3 1/4" aluminum cap stamped to indicate the corner position as follows: R.M. #1 - N27'E, 78.38 feet with a steel sign post 1.16 feet away; R.M.#2 - N31°W, 95.49 feet with a steel sign post 0.95 feet away; top of hydrant - N87°E, 43.51 feet; 8" oak - N20°E, 97.75 feet; R pole #6-91/50 - N77°W, 65.43 feet.


SEE SKETCH ON BACK

28410

28410 LAKD

JOHN R. GARSKE LAND SURVEYOR No.

IGAN STATE BOARD OF LAND SURVEYORS, JAN. 28, 1971 REVISED MAY 14, 1975 REVISED JAN., 1983

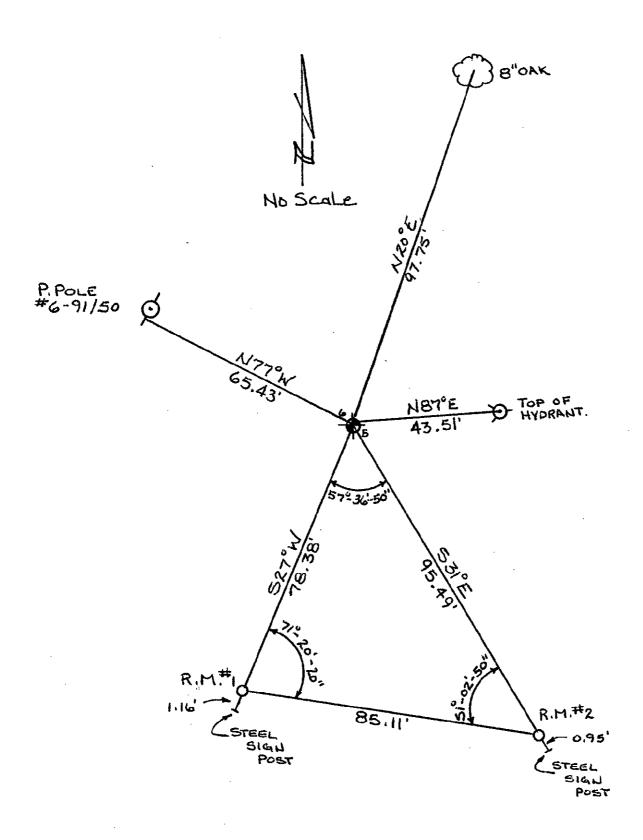

47-45, C-2

SURVEY & REMONUMENTATION

SEP 2 9 1994

Fair mar China Rhamana man a trong