

**LAND CORNER RECORDATION CERTIFICATE**  
**Filing Requirement of Act 74, Mich. P.A. 1970**

Register's Office }  
 Gogebic County } ss.

For corners in  
Gogebic

(County)

Located In:

Corner Code #

- |                                    |   |            |   |            |
|------------------------------------|---|------------|---|------------|
| 1. Public Land Survey Sec. 5       | T | <u>47N</u> | R | <u>45W</u> |
|                                    | T | _____      | R | _____      |
|                                    | T | _____      | R | _____      |
|                                    | T | _____      | R | _____      |
| 2. Property Controlling in Section | S | _____      | T | _____      |
|                                    | S | _____      | T | _____      |
| 3. Miscellaneous Property in Sec.  | S | _____      | T | _____      |
|                                    | S | _____      | T | _____      |

C-2  
Seg. #2

Received for record the  
15<sup>TH</sup> day of December  
 A. D. 1995 at 10:15 o'clock  
A m., and recorded in  
 Liber 5 of CORNERS  
 on page 308.  
Ramona Collins Deputy  
 Register of Deeds

Register of Deeds Stamp & File Number

4. Lot No. \_\_\_\_\_, Recorded Plat \_\_\_\_\_  
 5. Private Claims \_\_\_\_\_

One-quarter corner common to Sections 5 & 6

I, John P. Goss, in a field survey on October 19, 1995, do hereby certify that under requirements of P.A. 74, Michigan P.A. of 1970, the corner points mentioned in lines 1 and 2 above were in conformance with regulations and rules therefore as required in the current manual of survey instructions of the United States Department of the Interior, Bureau of Land Management or by a decree of a Court of Law and/or that the corner points mentioned in lines 3, 4 and 5 above were in conformance with the rules of the Michigan Board of Land Surveyors or by a Decree of a Court of Law; established, re-established, monumented, re-monumented, recovered, found as expressed below:

A	B	C	D	E	F	G	H	I	J	K	L	M
2	6	5	4	3	2	1						
3												
4	7	8	9	10	11	12						
5												
6	18	17	16	15	14	13						
7												
8	19	20	21	22	23	24						
9												
10	30	29	28	27	26	25						
11												
12	31	32	33	34	35	36						
13												

**NOTE: Not more than 4 corners, all in the same town and range, may be recorded on this certificate.**

A. Description of original monument and accessories and/or subsequent restoration:

Survey by William Burt in 1848, set ironwood post from which a 8" Y. Birch bearing S16°W, 11 links and a 10" fir bearing N70°E, 10 links.  
 - 1971 Plat of Indian Hills - shows corner position.  
 - 1974 Plat of Indian Hills - shows corner position.  
 - 1981 John P. Goss using plat monuments set 1" iron pin and recorded it in Liber 2 of land corners page 128.  
 - 1995 John R. Garski found 1" iron pin accessories: R.M.#1=N27°E, 78.38' / steel sign-1.16'; R.M.#2=N31°W, 95.49' / steel sign- 0.95'; top of hydrant- N87°E, 43.51'; 8" Oak-N20°E, 97.75'; P.Pole #6-91/50-N77°W, 65.43'.

B. Description of corner evidence found and/or method applied in restoring or reestablishing corner:


1995 I found a 1" iron rod marking corner position which checks with Garski certification as noted above. I updated the accessories as noted below to bring it up to state and county specification.

Act 74 reseach on file with County Register of Deeds Office.

C. Description of monument for corner and accessories established to perpetuate locating the position of the corner:

Set a 3/4" by 30" iron pin inside monument box. I established the following bearing trees and reference objects. 2 reference monument consisting of 2 1/2" x30" aluminum pipe with a 3/4" aluminum cap stamped to indicate the corner position as follows: R.M. #1 - N27°E, 78.38 feet with a steel sign post 1.16 feet away; R.M. #2 - N31°W, 95.49 feet with a steel sign post 0.95 feet away; top of hydrant - N87°E, 43.51 feet; 8" oak - N20°E, 97.75 feet; P.Pole #6-91/50 - N77°W, 65.43 feet.

PEER GROUP APPROVED  
Richard H. Dean 12/14/95  
 COUNTY REPRESENTATIVE

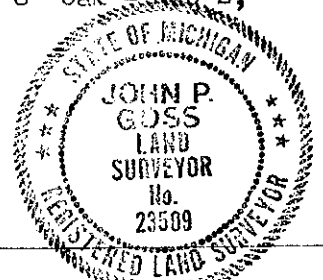

Signed by John P Goss Date 11-7-95  
 Surveyor's Michigan License No. 23509

Gogebic County Road Commission